

JACKSON  
 P 260  
 9-64

MISSISSIPPI  
 BOARD OF WATER COMMISSIONERS  
 416 North State Street  
 Jackson, Mississippi 39201

WATER WELL DRILLERS LOG

Sept 21 1964 Coble Water Supply Jackson  
 date well completed firm name county well located

LANDOWNER: G.S. McHown  
Breakwater, Miss  
 (mailing address)

WELL LOCATION:  
 sec. 2 T 7 N R 6 E  
 3 miles N of Boac  
 (distance) (direction) (nearest town)

WELL PURPOSE: home  
 (home, irrigation, municipal, industrial)

- WELL COMPLETION DATA:
- (1) diameter (inches) 1 1/4
  - (2) total depth (feet) 257
  - (3) static water level (feet) 5' <sup>below</sup> <sub>above</sub> top of ground.
  - (4) casing Galv 249  
 (material) (depth)
  - (5) screen 8' 249  
 (length) (depth to top)  
1 1/4 Copper galv  
 (size) (material)
  - (6) pump \_\_\_\_\_  
 (HP) (yield gpm)  
 (type power) \_\_\_\_\_
  - (7) electric log no  
 (yes or no)  
 (organization running log) \_\_\_\_\_
  - (8) how well bottom plugged BD Valve

description of formations encountered	from	to
yellow clay	0	18
soft blue clay	18	25
sand and gravel	25	100
clay	100	235
stratified clay and sand	235	242
sand	242	257


MAY 27 1968

MISS. BOARD OF  
 WATER COMMISSIONERS

DRILLERS REMARKS: Pump installed by owner

If well telescopes please sketch and show depths.

GROUND LEVEL

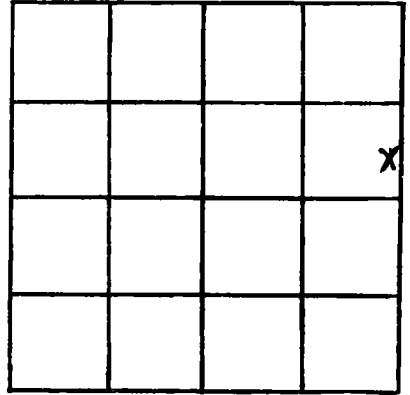

SECTION 2

Please indicate well location X.

ADDITIONAL INFORMATION

If more than one screen, show locations of each on sketch.