

Jackson
 P 261
 8-68

MISSISSIPPI
 BOARD OF WATER COMMISSIONERS
 416 North State Street
 Jackson, Mississippi 39201

CODED

WATER WELL DRILLERS LOG

8-29-1968 Lynn Central Co. Jackson
 date well completed firm name county well located

LANDOWNER:
City of Moss Point
Moss Point, Miss.
 (mailing address)


WELL LOCATION: Sue Ellen Street
 sec. 36 T 7 N R. 6 E
 (distance) miles (direction) of (nearest town)

WELL PURPOSE: Municipal
 (home, irrigation, municipal/industrial)

WELL COMPLETION DATA:

- (1) diameter (inches) 16"
- (2) total depth (feet) 812'
- (3) static water level (feet) 84 below above-top of ground.
- (4) casing Steel, 752',
 (material) (depth)
16" if telescope see back.
 (size)
- (5) screen 50', 752'
 (length) (depth to top)
10", Stainless Steel
 (size) (material)
- (6) pump _____ (HP) _____ (yield gpm)
Electric
 (type power)
- (7) electric log yes
 (yes or no)
Schlumberger
 (organization running log)
- (8) how well bottom plugged Valve


description of formations encountered	from	to
<u>yellow sandy clay</u>	<u>0</u>	<u>10</u>
<u>blue sandy clay</u>	<u>10</u>	<u>40</u>
<u>sand</u>	<u>40</u>	<u>172</u>
<u>sandy clay</u>	<u>172</u>	<u>260</u>
<u>sandy siltstone or clay</u>	<u>260</u>	<u>318</u>
<u>shaly hard & soft shales</u>	<u>318</u>	<u>730</u>
<u>sand, fine</u>	<u>730</u>	<u>735</u>
<u>clay</u>	<u>735</u>	<u>753</u>
<u>silt</u>	<u>753</u>	<u>808</u>
<u>sandy clay</u>	<u>808</u>	<u>817</u>

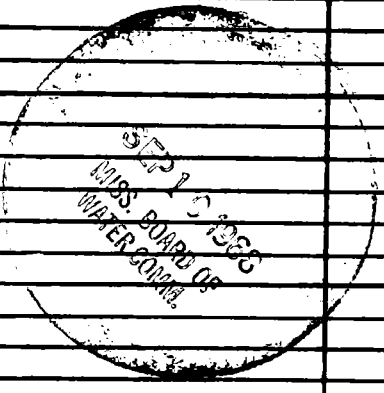

DRILLERS REMARKS:
Pump not installed as of this date.

If well telescopes please sketch and show depths.

GROUND LEVEL

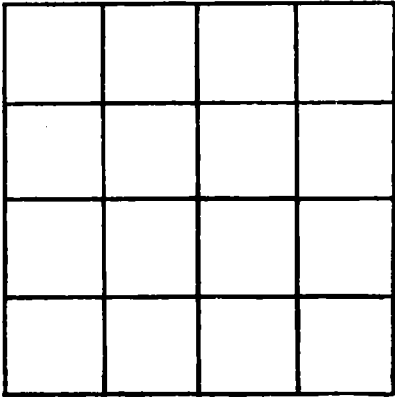

SECTION _____

Please indicate well location X.

ADDITIONAL INFORMATION

A series of horizontal lines for writing additional information, starting below the 'ADDITIONAL INFORMATION' header and extending to the bottom of the page.

If more than one screen, show locations of each on sketch.