

P262-1588
8-19-60

WATER WELL DRILLERS LOG **CODED**

0 30

Date: Aug. 19, 1960, Driller: L. L. Garland County Jackson
(Name)

(1) Owner of Land: W. V. Burns
(Name)
Pascagoula, Miss.
(Address)

(2) Location: 1/4, 1/4, Sec. 1 T8 R6,
10 miles East, of O.S.
(distance) (direction) (Nearest Town)

(3) Topography: Flat
(Hilly) (Flat) (Level)

(4) Purpose of Well: Domestic
(Domestic Irrigation
Municipal, Industrial, Other)

Description & Color of Materials Sand, Clay, Red Clay, Shell, etc.	Thick- ness Feet	Depth Feet
<u>Sand</u>	<u>18</u>	
<u>Blue Clay</u>	<u>34</u>	
<u>Sand</u>	<u>9</u>	
<u>Blue Clay</u>	<u>8</u>	
<u>Sand</u>	<u>8</u>	
<u>Blue Clay</u>	<u>20</u>	
<u>Sand</u>	<u>35</u>	

Information upon completion of well:

(1) Diameter 2" inches.

(2) Total Depth 132' feet.

(3) Water Level 9' feet below top of ground.

(4) Cased to _____, Size _____

(5) Screen: Size 2", Length 6'


(6) Were any formations sealed against pollution?
_____ yes, _____ no.

CODED

If YES depth of formation _____

Why _____

Drillers Remarks: _____

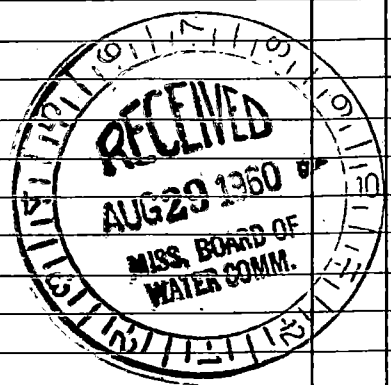

Well

(Use Back Side)

