

CODED

MISSISSIPPI  
BOARD OF WATER COMMISSIONERS  
416 North State Street  
Jackson, Mississippi 39201

CODED

WATER WELL DRILLERS LOG

JACKSON  
P 266  
1-20-69

1-20 1969 Coast Water Well Serv Jackson  
date well completed firm name county well located

LANDOWNER: Jimmie Mughler

description of formations encountered	from	to
<u>marsh muck + blue clay</u>	<u>0</u>	<u>20</u>
<u>sand fine to med</u>	<u>20</u>	<u>38</u>
<u>blue clay + sandy shale</u>	<u>38</u>	<u>150</u>
<u>fine sand</u>	<u>150</u>	<u>165</u>
<u>blue clay + sandy shale</u>	<u>165</u>	<u>210</u>
<u>sand fine, med-coarse</u>	<u>210</u>	<u>290</u>

Mountain, Miss.  
(mailing address)

WELL LOCATION:

sec 9 T 8 N R 6 E  
S W  
4 miles W of Pascagoula  
(distance) (direction) (nearest town)

WELL PURPOSE: Home  
(home, irrigation, municipal, industrial)

WELL COMPLETION DATA:

- (1) diameter (inches) 2"
- (2) total depth (feet) 290
- (3) static water level (feet) 13 below above top of ground.
- (4) casing plastic, 280'  
(material) (depth)  
2"  
(size) if telescope see back.
- (5) screen 10', 280'  
(length) (depth to top)  
2", plastic  
(size) (material)
- (6) pump 1/3, 12  
(HP) (yield gpm)  
Elec.  
(type power)
- (7) electric log N/O  
(yes or no)  
(organization running log)
- (8) how well bottom plugged Back  
Wash Valve

CODED


JAN 24 1969

DRILLERS REMARKS:

MISS. B.O. OF  
WATER COMM

If well telescopes please sketch and show depths.

GROUND LEVEL

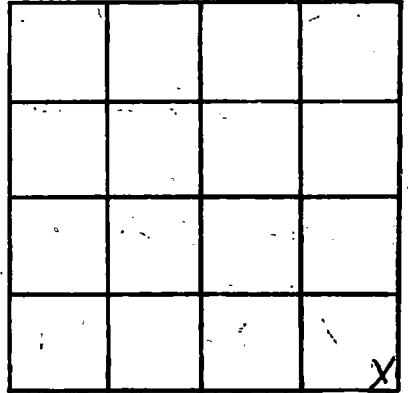

SECTION 4

Please indicate well location X.

ADDITIONAL INFORMATION

If more than one screen, show locations of each on sketch.