

Jackson  
P 268  
6-68

MISSISSIPPI  
BOARD OF WATER COMMISSIONERS  
416 North State Street  
Jackson, Mississippi 39201

~~CODED~~

WATER WELL DRILLERS LOG

6-18 1968 date well completed  
Switzer Well Co. firm name  
Jackson county well located

LANDOWNER: Gautier Park

description of formations encountered

from

to

Association

clay

0

4

Gautier, Miss.

sand

4

14

(mailing address)

clay

14

52

WELL LOCATION:

sand

52

63

sec 3 T 8 R 6 E

good sand

63

83

IN GAUTIER

gravel

83

134

(distance) miles (direction) of (nearest town)

hard

134

165

WELL PURPOSE:

good sand

165

186

(home, irrigation, municipal, industrial)

mixed

186

229

WELL COMPLETION DATA:

fair sand

229

251

(1) diameter (inches)

good sand

250

290

(2) total depth (feet)

sand

290

300

(3) static water level (feet) 31 below top of ground.

good clay

300

309

(4) casing gal. steel 3 7/8" (material) 377' (depth)

mixed

309

330

2" (size) If telescope see back.

clay

330

340

(5) screen 10' (length) 377' (depth to top)

fine sand

340

359

8 ga. (size) 55 (material) or pipe

good sand

353

373

(6) pump 1/2 (HP) 8.5 (yield gpm)

sand gravel

373

389

electric (type power)

(7) electric log No (yes or no)

~~CODED~~

(organization running log)


(8) how well bottom plugged Back pressure valve

DRILLERS REMARKS:

JUL 5 10 55 AM  
MISS. Bd. of WATER CONTROL

If well telescopes please sketch and show depths.

GROUND LEVEL

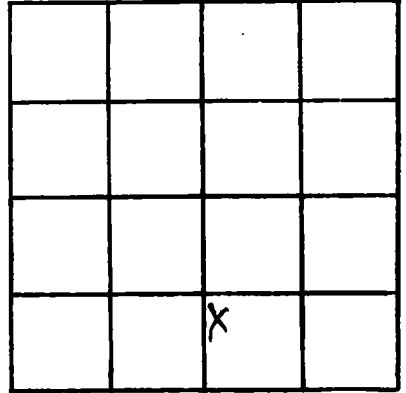

SECTION 3

Please indicate well location X.

ADDITIONAL INFORMATION

A series of horizontal lines for writing additional information.

If more than one screen, show locations of each on sketch.