

CODED

MISSISSIPPI
BOARD OF WATER COMMISSIONERS
416 North State Street
Jackson, Mississippi 39201

WATER WELL DRILLERS LOG

Jackson
P 269
7-20-65

July 20 1965 date well completed
Labille Water Supply firm name
Jackson county well located

LANDOWNER: J. S. Stearman
Gautier - Miss
(mailing address)


WELL LOCATION:
sec. 8 T 7 N R 6 E
13 miles West of rand
(distance) (direction) (nearest town)

WELL PURPOSE:
(home, irrigation, municipal, industrial)

WELL COMPLETION DATA:
(1) diameter (inches) 2"
(2) total depth (feet) 782
(3) static water level (feet) 3" below top of ground. above
(4) casing galv (material) (depth) _____
(size) _____ If telescope see back.
(5) screen 10 (length) 772 (depth to top)
2" (size) Stamlers (material)
(6) pump _____ (HP) _____ (yield gpm)
(type power) _____
(7) electric log no (yes or no)
(organization running log) _____
(8) how well bottom plugged BPD valve


description of formations encountered	from	to
Clay and sandy clay	0	60
sand and gravel	60	115
Clay	115	198
sand	198	242
Clay	242	374
sand	374	408
Clay	408	720
sand	720	782

DRILLERS REMARKS: Pump installed by owner

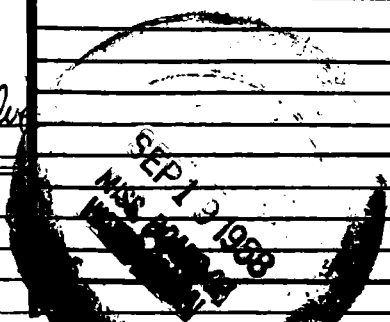

If well telescopes please sketch and show depths.

GROUND LEVEL

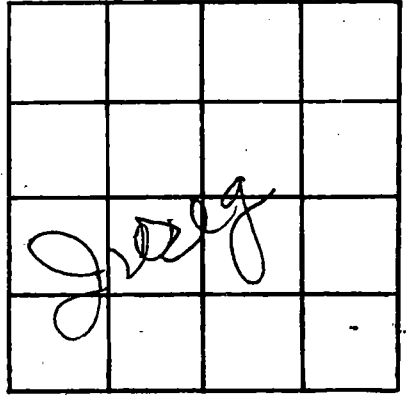

SECTION 8

Please indicate well location X.

ADDITIONAL INFORMATION

If more than one screen, show locations of each on sketch.