

Jackson  
 P210  
 10-20-64

MISSISSIPPI  
 BOARD OF WATER COMMISSIONERS  
 416 North State Street  
 Jackson, Mississippi 39201

INDEXED

WATER WELL DRILLERS LOG

Oct 20 1964 Chall Water Sup. Jackson  
 date well completed firm name county well located

LANDOWNER: Harold Monroe  
Miss Point, Miss  
 (mailing address)

description of formations encountered	from	to
clay	0	22
sand	22	30
clay	30	80
sand	80	150
clay	150	328
sand	328	346

WELL LOCATION:  
 sec. 2 T. 7 N. R. 1 E.  
5 miles N of Miss Point  
 (distance) (direction) (nearest town)

WELL PURPOSE: camp  
 (home, irrigation, municipal, industrial)

WELL COMPLETION DATA:

(1) diameter (inches) 2

(2) total depth (feet) 346

(3) static water level (feet) 2 below top of ground. above

(4) casing (material) \_\_\_\_\_ (depth) \_\_\_\_\_  
 (size) \_\_\_\_\_ if telescope see back.


(5) screen 5' 341  
 (length) (depth to top)  
2" stainless  
 (size) (material)

(6) pump \_\_\_\_\_ (HP) \_\_\_\_\_ (yield gpm)  
 (type power) \_\_\_\_\_

(7) electric log no  
 (yes or no)  
 (organization running log) \_\_\_\_\_


(8) how well bottom plugged B.P. Palov

DRILLERS REMARKS: pump installed by owner

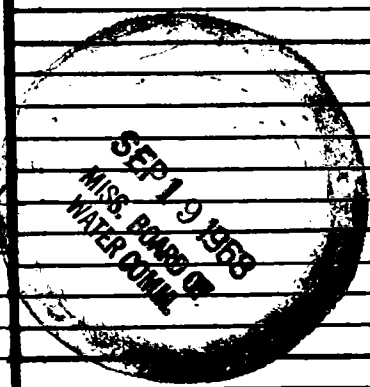

If well telescopes please sketch and show depths.

GROUND LEVEL

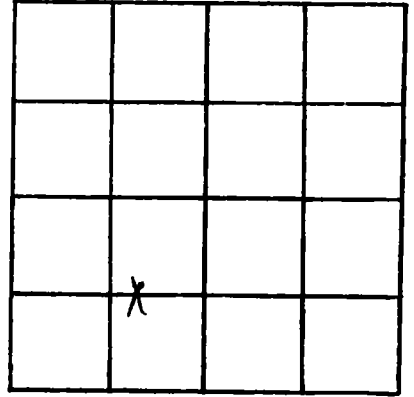

SECTION 2

Please indicate well location X.

ADDITIONAL INFORMATION

If more than one screen, show locations of each on sketch.