

CODED


MISSISSIPPI
BOARD OF WATER COMMISSIONERS
416 North State Street
Jackson, Mississippi 39201

Jackson
P 211
7-3-65

WATER WELL DRILLERS LOG


July 3 1965 Catfish Water Supply Jackson
date well completed firm name county well located

LANDOWNER: <u>C. Griffin</u>	description of formations encountered	from	to
<u>Escatawpa</u> (mailing address)	clay sand	0 22	22 6.4
WELL LOCATION: sec. <u>20</u> T. <u>7</u> N. R. <u>6</u> E. <u>3</u> miles <u>North</u> of <u>MP</u> (distance) (direction) (nearest town)			
WELL PURPOSE: <u>Home</u> (home, irrigation, municipal, industrial)			
WELL COMPLETION DATA: (1) diameter (inches) <u>1 1/4</u> (2) total depth (feet) <u>68</u> (3) static water level (feet) <u>11-6</u> <u>below</u> top of ground. (4) casing <u>Galv</u> (material), (depth) <u>1 1/4</u> (size) if telescope see back. (5) screen <u>5</u> (length), <u>63</u> (depth to top) <u>1 1/4</u> (size), <u>plastic</u> (material) (6) pump (HP) (yield gpm) (type power) (7) electric log <u>no</u> (yes or no) (organization running log) (8) how well bottom plugged <u>B.P. Valve</u>			
DRILLERS REMARKS: <u>Pump installed by owner</u>			

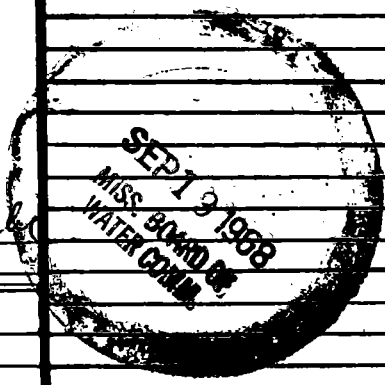

If well telescopes please sketch and show depths.

GROUND LEVEL

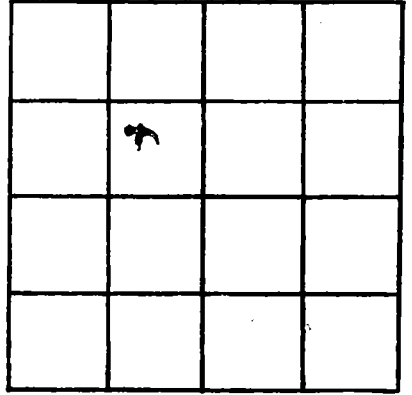

SECTION _____

Please indicate well location X.

ADDITIONAL INFORMATION

If more than one screen, show locations of each on sketch.