

Jackson
P 272.
10-19-64


MISSISSIPPI
BOARD OF WATER COMMISSIONERS
416 North State Street
Jackson, Mississippi 39201

CODED

WATER WELL DRILLERS LOG

Oct 19 1964 Colville Water Supply Jackson
date well completed firm name county well located

LANDOWNER: <u>B. J. Beasley</u>	description of formations encountered	from	to
Bayou La Boute, Miss. (mailing address)	Clay Clay & sand streaks sand	2 75 52	75 88 100
WELL LOCATION: sec <u>10</u> T <u>8</u> N R <u>6</u> E (distance) miles (direction) of (nearest town)			
WELL PURPOSE: <u>home</u> (home, irrigation, municipal, industrial)			
WELL COMPLETION DATA: (1) diameter (inches) <u>2"</u> (2) total depth (feet) <u>100</u> (3) static water level (feet) <u>19-6</u> ^{below} _{above} top of ground (4) casing <u>plastic</u> (material) (depth) (size) if telescope see back. (5) screen <u>5'</u> <u>95</u> (length) (depth to top) <u>2"</u> <u>plastic</u> (size) (material) (6) pump _____ (HP) _____ (yield gpm) (type power) (7) electric log _____ (yes or no) (organization running log) (8) how well bottom plugged <u>Bp Valley</u>			
DRILLERS REMARKS: <u> pump installed by owner</u>			

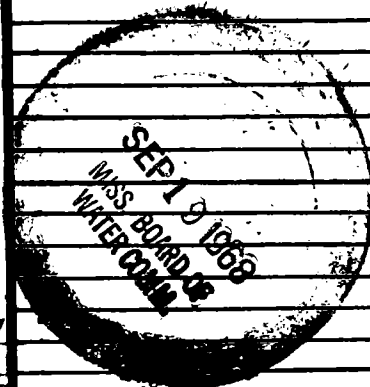

If well telescopes please sketch and show depths.

GROUND LEVEL

/			X
/			

SECTION 28

Please indicate well location X.

ADDITIONAL INFORMATION

If more than one screen, show locations of each on sketch.