

Jackson
 P 213
 5-20-65

MISSISSIPPI
 BOARD OF WATER COMMISSIONERS
 416 North State Street
 Jackson, Mississippi 39201

CODED

WATER WELL DRILLERS LOG

May 20 1965 data well completed
 Cobble White Sup. firm name
 Jackson county well located

LANDOWNER: Earl Mc Kee
Panopolis Miss
 (mailing address)

description of formations encountered	from	to
<u>Sandy clay streaks and clay sand</u>	<u>0</u>	<u>66</u>
	<u>66</u>	<u>89</u>

WELL LOCATION:
 sec. 8 T. 8 N. R. 6 E
Panopolis
 (distance) (direction) (nearest town)

WELL PURPOSE: irrigation
 (home, irrigation, municipal, industrial)

WELL COMPLETION DATA:

(1) diameter (inches) 1 1/4

(2) total depth (feet) 89

(3) static water level (feet) 15 below top of ground.

(4) casing galv (material) (depth)

(size) if telescope see back.

(5) screen 5 (length) 84 (depth to top)

1 1/4 (size) Copper gauze (material)

(6) pump (HP) (yield gpm)


(type power)

(7) electric log no (yes or no)

(organization running log)

(8) how well bottom plugged B.P. White


DRILLERS REMARKS: pump installed by owner

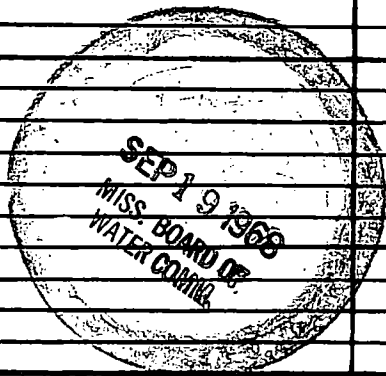

CODED

If well telescopes please sketch and show depths.

GROUND LEVEL

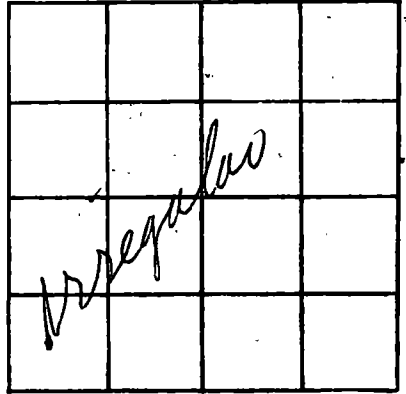

SECTION 8

Please indicate well location X.

ADDITIONAL INFORMATION

If more than one screen, show locations of each on sketch.