

CODED

Jackson
P 27A
6-7-65

MISSISSIPPI
BOARD OF WATER COMMISSIONERS
416 North State Street
Jackson, Mississippi 39201

WATER WELL DRILLERS LOG

June 7 1965 Capella Water Supply Jackson
date well completed firm name county well located


LANDOWNER: George
McDonald
Georgetown Main
(mailing address)

description of formations encountered	from	to
Clay and silt	0	44
sand and gravel	44	160
Clay	160	352
sand	352	356

WELL LOCATION:
sec. 2 T. 7 N. R. 6 E.
4 miles North of M.P.
(distance) (direction) (nearest town)

WELL PURPOSE: camp
(home, irrigation, municipal, industrial)


- WELL COMPLETION DATA:
- (1) diameter (inches) 2"
 - (2) total depth (feet) 356
 - (3) static water level (feet) 4 below top of ground. above
 - (4) casing galv (material), (depth) _____
If telescope see back. (size) _____
 - (5) screen 4, 252 (length), (depth to top)
2, stainless (size), (material)
 - (6) pump _____ (HP) _____ (yield gpm)
(type power) _____
 - (7) electric log no (yes or no)
(organization running log) _____
 - (8) how well bottom plugged BPV

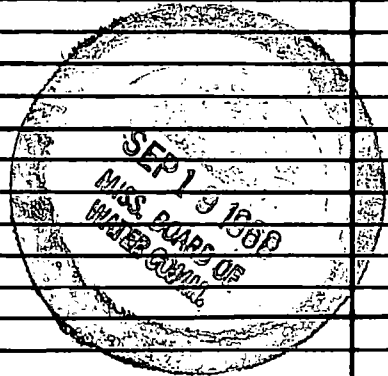

DRILLERS REMARKS: Pump installed by owner

If well telescopes please sketch and show depths.

GROUND LEVEL

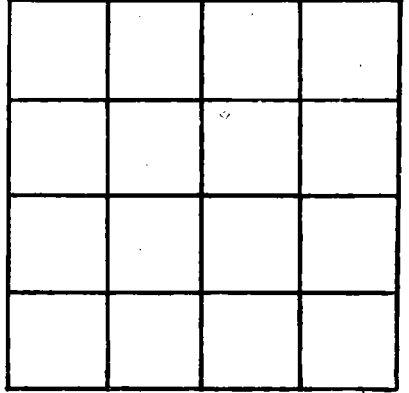

SECTION 2

Please indicate well location X.

ADDITIONAL INFORMATION

If more than one screen, show locations of each on sketch.