

Jackson
P215
5-11-65

MISSISSIPPI
BOARD OF WATER COMMISSIONERS
416 North State Street
Jackson, Mississippi 39201

CODED

WATER WELL DRILLERS LOG

May 11 1965 Colwell Water Supply Jackson
date well completed firm name county well located

LANDOWNER: O. L. Johnston
Mon Point Miss
(mailing address)


description of formations encountered	from	to
		22
<u>sand and clay streak</u>	<u>0</u>	<u>22</u>
<u>slay</u>	<u>22</u>	<u>60</u>
<u>gravel</u>	<u>60</u>	<u>89</u>
		130
<u>clay</u>	<u>130</u>	<u>176</u>
<u>stink</u>	<u>176</u>	<u>215</u>

WELL LOCATION:
sec. 10 T. 1 N. R. 4 E.
Mon Point
(distance) miles (direction) of (nearest town)

WELL PURPOSE: Drinking
(home, irrigation, municipal, industrial)

- WELL COMPLETION DATA:
- (1) diameter (inches) 2"
 - (2) total depth (feet) 215
 - (3) static water level (feet) 19 ^{below} above top of ground.
 - (4) casing galv (material) (depth)
 - (5) screen 5 (length) 210 (depth to top)
2' (size) Stainless (material)
 - (6) pump (HP) (yield gpm)
(type power)
 - (7) electric log no (yes or no)
(organization running log)
 - (8) how well bottom plugged B.P. Valves

DRILLERS REMARKS: pump installed by owner

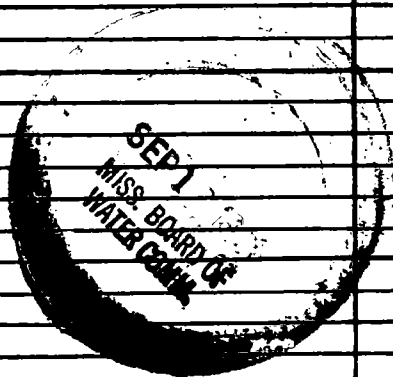

If well telescopes please sketch and show depths.

GROUND LEVEL

X			

SECTION 10

Please indicate well location X.

ADDITIONAL INFORMATION

If more than one screen, show locations of each on sketch.