

CODED

MISSISSIPPI
BOARD OF WATER COMMISSIONERS
416 North State Street
Jackson, Mississippi 39201

WATER WELL DRILLERS LOG

Jackson
P 216
8-27-65

Aug 27 1965 date well completed
Cordova Water Supply firm name
Jackson county well located

LANDOWNER: Clyde
Oliver
Goetzman
(mailing address)


description of formations encountered	from	to
Clay and mud shale	0	22
sand	22	69

WELL LOCATION:
sec 24 T 7 N R 6 E
3 miles North of M.P.
(distance) (direction) (nearest town)

WELL PURPOSE: Home
(home, irrigation, municipal, industrial)


- WELL COMPLETION DATA:
- (1) diameter (inches) 1 1/4
 - (2) total depth (feet) 109
 - (3) static water level (feet) 10 below above top of ground.
 - (4) casing galv (material), (depth)
 - (size) If telescope see back.
 - (5) screen 5 (length), 64 (depth to top)
 - 1/4 (size), Copper gauze (material)
 - (6) pump (HP) (yield gpm)
 - (type power)
 - (7) electric log no (yes or no)
 - (organization running log)
 - (8) how well bottom plugged B.P. Value

DRILLERS REMARKS:

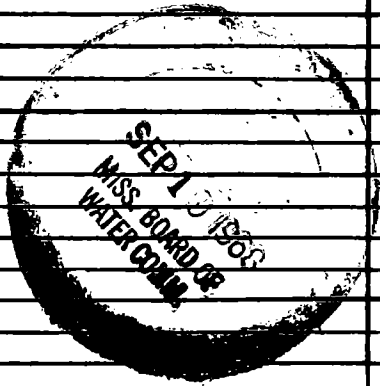

If well telescopes please sketch and show depths.

GROUND LEVEL

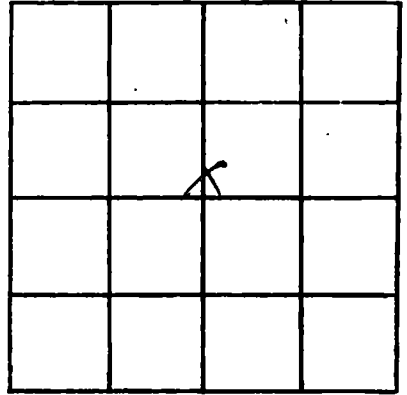

SECTION 12

Please indicate well location X.

ADDITIONAL INFORMATION

If more than one screen,
show locations of each on sketch.