

CODED

MISSISSIPPI
BOARD OF WATER COMMISSIONERS
416 North State Street
Jackson, Mississippi 39201

WATER WELL DRILLERS LOG

Jackson
P277
6-8-68

6-8 1968 Coast Water Well Serv. Jackson
date well completed firm name county well located

LANDOWNER: J.C. Runnels

description of formations encountered

from to

P.O. Box 1342
Pascagoula, Miss.
(mailing address)

Red Clay 0 14
Topsoil 14 34
Blue Clay 34 63
Sand mud 63 88

WELL LOCATION:

sec. 2 T. 8 N. R. 6 W.
S W
city miles limits of Pascagoula
(distance) (direction) (nearest town)

WELL PURPOSE: pond irrigation
(home, irrigation, municipal, industrial)

WELL COMPLETION DATA:

- (1) diameter (inches) 2"
- (2) total depth (feet) 88
- (3) static water level (feet) 10' below top of ground
- (4) casing 2" galv. 84'
(material) (depth)
- 2"
(size) if telescope see back.
- (5) screen 4' 84'
(length) (depth to top)
- 2" All Stainless
(size) (material)
- (6) pump 1 1/2 24
(HP) (yield gpm)
- Electric
(type power)
- (7) electric log NO
(yes or no)

(organization running log)

(8) how well bottom plugged Back
subsh valve


DRILLERS REMARKS:

DEC 15 1966

MISS. BD. OF
WATER COMM.

If well telescopes please sketch and show depths.

GROUND LEVEL

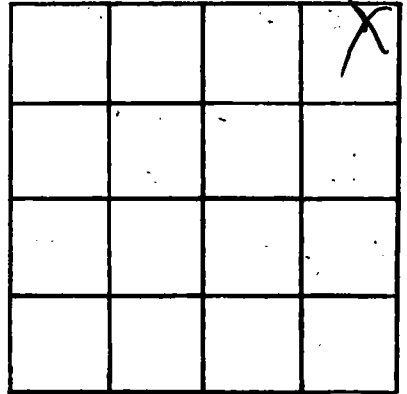

SECTION 2

Please indicate well location X.

ADDITIONAL INFORMATION

If more than one screen, show locations of each on sketch.