

CODED

Jackson
P 219
5-12-65

MISSISSIPPI
BOARD OF WATER COMMISSIONERS
416 North State Street
Jackson, Mississippi 39201

WATER WELL DRILLERS LOG

May 19 1965 *Chelle Water* firm name *Jackson* county well located

LANDOWNER: *W.B. Robertson*
Persepolis Miss
(mailing address)


description of formations encountered	from	to
<i>Struck</i>	<i>0</i>	<i>22</i>
<i>sand</i>	<i>22</i>	<i>35</i>
<i>Clay</i>	<i>35</i>	<i>60</i>
<i>bed</i>	<i>60</i>	<i>83</i>

WELL LOCATION:
sec *6* T *8* N R *6* E
S W
Persepolis
miles of (nearest town)

WELL PURPOSE: *irrigation*
(home, irrigation, municipal, industrial)

- WELL COMPLETION DATA:
- (1) diameter (inches) *1 1/4*
 - (2) total depth (feet) *83*
 - (3) static water level (feet) *4* below top of ground
 - (4) casing *galv* (material), (depth)
 - (5) screen *5'* (length), *78* (depth to top)
1/4 (size), *ropper gauge* (material)
 - (6) pump (HP) (yield gpm)
(type power)
 - (7) electric log *no* (yes or no)
(organization running log)
 - (8) how well bottom plugged *BP Valve*

DRILLERS REMARKS: *muug installed by owner*

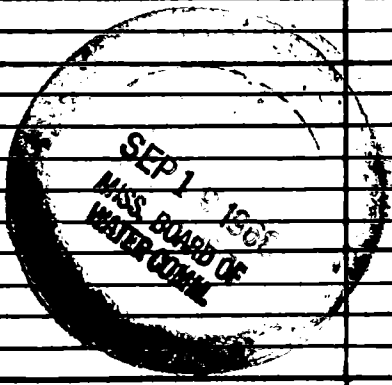

If well telescopes please sketch and show depths.

GROUND LEVEL

irregular sect.

SECTION 6

Please indicate well location X.

ADDITIONAL INFORMATION

If more than one screen, show locations of each on sketch.