

**MISSISSIPPI
BOARD OF WATER COMMISSIONERS**
416 North State Street
Jackson, Mississippi 39201

CODED

WATER WELL DRILLERS LOG

Jackson.
P 280
8-64

Aug 16 1964 Cabille Water Supply Jackson
date well completed firm name county well located

LANDOWNER: Boston
Hornes
Boston, Miss
(mailing address)

description of formations encountered	from	to
clay	0	50
sand	50	80
clay	80	210
sand	210	262

WELL LOCATION:
sec. 8 T. 7 N. R. 6 E.
6 miles W of Jaxson
(distance) (direction) (nearest town)

WELL PURPOSE: home
(home, irrigation, municipal, industrial)

- WELL COMPLETION DATA:
- diameter (inches) 1 1/4
 - total depth (feet) 262
 - static water level (feet) 16 ^{below} above top of ground.
 - casing galv. 254'
(material) (depth)
(size) if telescope see back.
 - screen 8' 254
(length) (depth to top)
1 1/4 capillary gauge
(size) (material)
 - pump _____ (HP) _____ (yield gpm)
(type power)
 - electric log no
(yes or no)
(organization running log)
 - how well bottom plugged B.P. Kelly

CODED


MAR 10 1965

DRILLERS REMARKS: found
installed by owner

MISS. Bd. OF
WATER COMMISSIONERS

If well telescopes please sketch and show depths.

GROUND LEVEL

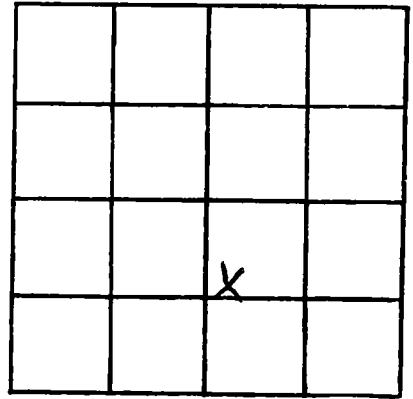

SECTION 8

Please indicate well location X.

ADDITIONAL INFORMATION

A series of horizontal lines for writing additional information, starting below the 'ADDITIONAL INFORMATION' header and extending down to the bottom of the page.

If more than one screen, show locations of each on sketch.