

Jackson
 P281
 10-65

MISSISSIPPI
 BOARD OF WATER COMMISSIONERS
 416 North State Street
 Jackson, Mississippi 39201

CODED

WATER WELL DRILLERS LOG

Oct 10 1965 White Water Supply Jackson
 date well completed firm name county well located

LANDOWNER: Willie Williams
Paroayuka
 (mailing address)

description of formations encountered	from	to
clay	0	60
sand	60	70

WELL LOCATION:
 sec. 36 T. 7 N. R. 6 E.
3 miles N of Paroayuka
 (distance) (direction) (nearest town)

WELL PURPOSE: home
 (home, irrigation, municipal, industrial)

WELL COMPLETION DATA:

(1) diameter (inches) 1 1/4

(2) total depth (feet) 70

(3) static water level (feet) 12 below top of ground

(4) casing galv (material) (depth)

 if telescope see back.
 (size)

(5) screen 5 65
 (length) (depth to top)

1 1/4 plaster
 (size) (material)

(6) pump (HP) (yield gpm)

 (type power)

(7) electric log no
 (yes or no)

 (organization running log)

(8) how well bottom plugged BAKED

CODED


MAR 10 1968

DRILLERS REMARKS: pump installed by owner

MISS. BD. OF
 WATER COMM.

If well telescopes please sketch and show depths.

GROUND LEVEL

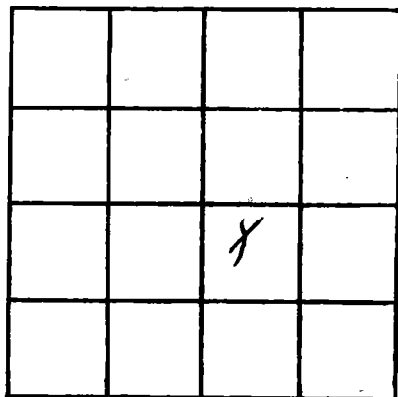

Drwg. 36
SECTION 36

Please indicate well location X.

ADDITIONAL INFORMATION

If more than one screen,
show locations of each on sketch.