

**MISSISSIPPI  
BOARD OF WATER COMMISSIONERS  
416 North State Street  
Jackson, Mississippi 39201**

**CODED**

**WATER WELL DRILLERS LOG**

Jackson  
P 282  
10-65

Oct 25 1965 Coble Water Supply Jackson  
date well completed firm name county well located

LANDOWNER: J. M. Butler  
Butler  
Yantis  
Miss  
(mailing address)

description of formations encountered	from	to
	clay mud	0
	148	220

WELL LOCATION:  
Sec 3 T 7 N R 6 E  
7 miles N of Yantis  
(distance) (direction) (nearest town)

WELL PURPOSE: home  
(home, irrigation, municipal, industrial)

WELL COMPLETION DATA:

(1) diameter (inches) 2

(2) total depth (feet) 220

(3) static water level (feet) 5 <sup>below</sup> <sub>above</sub> top of ground.

(4) casing galv  
(material) (depth)

\_\_\_\_\_ If telescope see back.  
(size)

(5) screen 5 215  
(length) (depth to top)

2 Stainless  
(size) (material)

(6) pump \_\_\_\_\_  
(HP) (yield gpm)

\_\_\_\_\_ (type power)

(7) electric log no  
(yes or no)

\_\_\_\_\_ (organization running log)

(8) how well bottom plugged B.P. Valve

**CODED**


DRILLERS REMARKS: pump installed by owner

MAR 10 1966

MISS. Bd. of WATER COMMISSIONERS

If well telescopes please sketch and show depths.

GROUND LEVEL

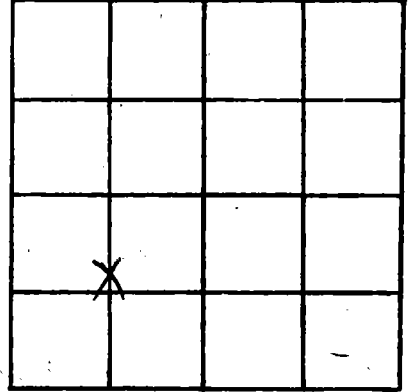

*July 3*  
SECTION

Please indicate well location X.

ADDITIONAL INFORMATION

If more than one screen, show locations of each on sketch.