

JACKSON
 P 284
 6-22-64

MISSISSIPPI
 BOARD OF WATER COMMISSIONERS
 416 North State Street
 Jackson, Mississippi 39201

WATER WELL DRILLERS LOG

June 22 1964 H. Cabell Water Supply Jackson
 date well completed firm name county well located

LANDOWNER: Seroy
Simms, Driffin Hts.
Miss Point
 (mailing address)

description of formations encountered	from	to
clay	0	15
sand	15	25
clay	25	42
sand	42	68

WELL LOCATION:
 15 sec. ~~7~~ T 7 N R 6 E W
Miss Point
 (distance) miles (direction) of (nearest town)

WELL PURPOSE: irrigation
 (home, irrigation, municipal, industrial)

WELL COMPLETION DATA:

(1) diameter (inches) 1 1/4

(2) total depth (feet) 68

(3) static water level (feet) 14 ^{below} above top of ground.

(4) casing galv 63
 (material) (depth)
 (size) If telescope see back.

(5) screen 5 63
 (length) (depth to top)
1 1/4 plastic
 (size) (material)

(6) pump _____ (HP) _____ (yield gpm)
 (type power)

(7) electric log no
 (yes or no)
 (organization running log)

(8) how well bottom plugged BPL

MAILED
 MAR 20 1969
 MISS. BO. OF WATER COM.


MAY 27 1968

MISS. BOARD OF WATER COM.

DRILLERS REMARKS: pump installed by owner

If well telescopes please sketch and show depths.

GROUND LEVEL

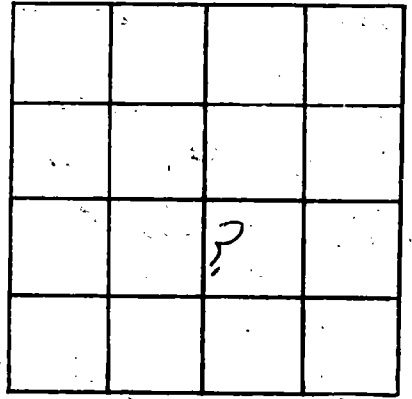

SECTION 10

Please indicate well location X.

ADDITIONAL INFORMATION

If more than one screen,
show locations of each on sketch.