

**MISSISSIPPI
BOARD OF WATER COMMISSIONERS**
416 North State Street
Jackson, Mississippi 39201

CODED

WATER WELL DRILLERS LOG

JACKSON
P 285
G-29-64

June 29 1964 Cobhill Water Supply Jackson
 date well completed firm name county well located

LANDOWNER: A.R. Crews

description of formations encountered	from	to

Osceola, Miss
 (mailing address)

<u>clay</u>	<u>0</u>	<u>42</u>
<u>sand</u>	<u>42</u>	<u>68</u>

WELL LOCATION:
 sec. R 7 N R 6 E
Osceola
 (distance) miles (direction) (nearest town)

WELL PURPOSE: home
 (home, irrigation, municipal, industrial)

WELL COMPLETION DATA:

- (1) diameter (inches) 1 1/4
- (2) total depth (feet) 68
- (3) static water level (feet) 10 1/2 ^{below} above top of ground.
- (4) casing gal. 63
 (material) (depth)
- _____ If telescope see back.
 (size)
- (5) screen 5 63
 (length) (depth to top)
- 1 1/4 brass gauge
 (size) (material)
- (6) pump _____
 (HP) (yield gpm)
- _____ (type power)
- (7) electric log no
 (yes or no)
- _____ (organization running log)
- (8) how well bottom plugged BT Valve

DRILLERS REMARKS: pump in stalled by owner

MAR 20 1968


MISS. BD. OF WATER COMM.

MAY 27 1968

MISS. BOARD OF WATER COMM.

If well telescopes please sketch and show depths.

GROUND LEVEL

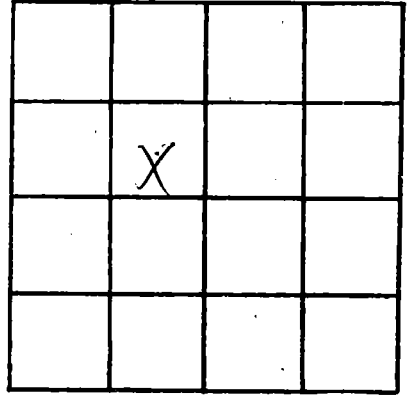

SECTION 9 12

Please indicate well location X.

ADDITIONAL INFORMATION

If more than one screen, show locations of each on sketch.