

JACKSON  
 P 286  
 7-8-64

MISSISSIPPI  
 BOARD OF WATER COMMISSIONERS  
 416 North State Street  
 Jackson, Mississippi 39201

CODED

WATER WELL DRILLERS LOG

July 8 1964 date well completed  
 Colville Water Supply firm name  
 Jackson county well located

LANDOWNER: Boyle  
 Crowley  
 Osatumpa Miss  
 (mailing address)

description of formations encountered	from	to
clay	0	40
sand	40	103
clay	103	167
sand	107	173

WELL LOCATION:  
 sec. 13 T 7 N R 6 E  
 Osatumpa  
 (distance) miles (direction) of (nearest town)

WELL PURPOSE: home  
 (home, irrigation, municipal, industrial)

WELL COMPLETION DATA:

(1) diameter (inches) 1 1/4

(2) total depth (feet) 173

(3) static water level (feet) 13 1/2 (below) above top of ground

(4) casing galv. 168 (material) (depth)

(size) if telescope see back.

(5) screen 5' 168 (length) (depth to top)

1/4 80 gauge copper (size) (material)

(6) pump (HP) (yield gpm)

(type power)

(7) electric log no (yes or no)

(organization running log)

(8) how well bottom plugged BP Vahy


CODED  
 MAR 20 1969  
 MISS. BD. OF WATER COMMISSIONERS  
 CODED

MAY 27 1968  
 MISS. BOARD OF WATER COMMISSIONERS

DRILLERS REMARKS: Pump installed by owner

If well telescopes please sketch and show depths.

GROUND LEVEL

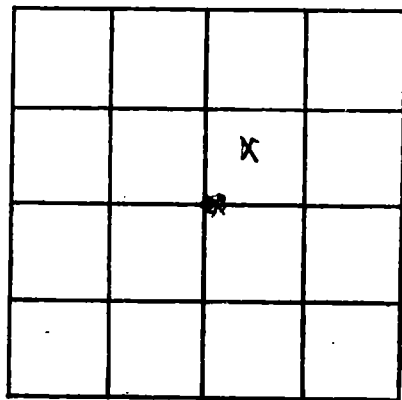

SECTION <sup>13</sup>~~12~~

Please indicate well location X.

ADDITIONAL INFORMATION

If more than one screen, show locations of each on sketch.