

JACKSON
 P 287
 7-13-64

MISSISSIPPI
 BOARD OF WATER COMMISSIONERS
 416 North State Street
 Jackson, Mississippi 39201

CODED

CODED

WATER WELL DRILLERS LOG

July 12 1964 Colville Water Supply Jackson
 date well completed firm name county well located

LANDOWNER: Paul Hudson
and David Porterin
Riverwood Pascagoula
 (mailing address)

description of formations encountered	from	to
	<u>Clay</u>	<u>0</u>
<u>sand</u>	<u>75</u>	<u>87</u>

WELL LOCATION:
 sec. 35 T 7 N R 6 E
Pascagoula
 (distance) miles (direction) of (nearest town)

WELL PURPOSE: irrigation
 (home, irrigation, municipal, industrial)

WELL COMPLETION DATA:

(1) diameter (inches) 1 1/4

(2) total depth (feet) 87

(3) static water level (feet) 20 ^{below} above top of ground.

(4) casing galv. 82
 (material) (depth)

 if telescope see back.
 (size)

(5) screen 5' 82
 (length) (depth to top)

1 1/4 Gauge (Corus)
 (size) (material)

(6) pump
 (HP) (yield gpm)

 (type power)

(7) electric log no
 (yes or no)

 (organization running log)

(8) how well bottom plugged B.P. Hudson

CODED

MISS. Bd. of WATER COMM.


MAY 27 1968

MISS. BOARD OF WATER COMM.

DRILLERS REMARKS: Drilling
installed by owner

If well telescopes please sketch and show depths.

GROUND LEVEL

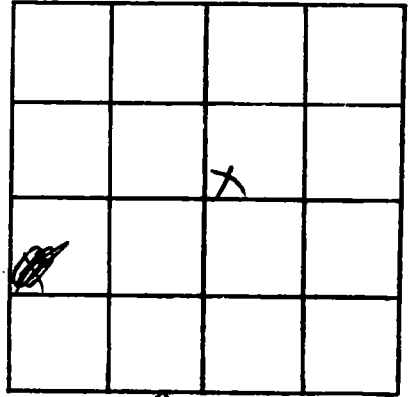

Greg 35
SECTION

Please indicate well location X.

ADDITIONAL INFORMATION

If more than one screen, show locations of each on sketch.