

150

CODED

MISSISSIPPI
 BOARD OF WATER COMMISSIONERS
 416 North State Street
 Jackson, Mississippi 39201

WATER WELL DRILLERS LOG

JACKSON
A 288
4-12-66

April 12, 1966 Colville Water Supply Co., Inc. Jackson
 Date well completed firm name county well located

LANDOWNER: F. T. Lee
200 Griffin St.
Moss Point, Miss.
 (mailing address)

description of formations encountered	from	to
	clay and sand streaks	0
clay	22	44
clam shells	44	66
Sand	66	72

WELL LOCATION:
 sec. 23 T 7 N R 6 E
Moss Point miles 1.5 of Point
 (distance) (direction) (nearest town)

WELL PURPOSE: irrigation
 (home, irrigation, municipal, industrial)

WELL COMPLETION DATA:

(1) diameter (inches) 2"

(2) total depth (feet) 72

(3) static water level (feet) 10 below above top of ground.

(4) casing galv 67
 (material) (depth)

_____ if telescope see back.
 (size)

(5) screen 5' 67
 (length) (depth to top)

2" plastic
 (size) (material)

(6) pump _____
 (HP) (yield gpm)

_____ (type power)

(7) electric log no
 (yes or no)

_____ (organization running log)


(8) how well bottom plugged BP/Valley

DRILLERS REMARKS: Installed by owner

MA
 MISS. REG. OF
 WATER CONTROL

If well telescopes please sketch and show depths.

GROUND LEVEL

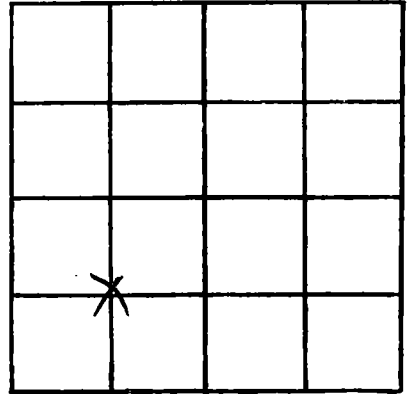

SECTION 23

Please indicate well location X.

ADDITIONAL INFORMATION

If more than one screen, show locations of each on sketch.