

CODED

CODED

JACKSON  
P 289  
4-20-66

MISSISSIPPI  
BOARD OF WATER COMMISSIONERS  
416 North State Street  
Jackson, Mississippi 39201

WATER WELL DRILLERS LOG

April 20 1966 Colville Water Supply Co. Inc. Jackson  
date well completed firm name county/well located

LANDOWNER: Town  
Market - Market  
St. Pascaoule  
at Inhabls (mailing address)

description of formations encountered	from	to
	clay	0
streaks of chert & sand	22	66
sand	66	84

WELL LOCATION:  
sec. 5 T. 8 N. R. 6 E  
Pascaoule  
(distance) miles (direction) of (nearest town)

WELL PURPOSE: Dom. Cond.  
(home, irrigation, municipal, industrial)

WELL COMPLETION DATA:  
(1) diameter (inches) 2"  
(2) total depth (feet) 84  
(3) static water level (feet) 16 <sup>below</sup> above top of ground.  
(4) casing galv 79  
(material) (depth)  
(size) If telescope see back.  
(5) screen 5' 79  
(length) (depth to top)  
2" plastic  
(size) (material)  
(6) pump 3/4 7  
(HP) (yield gpm)  
elec  
(type power)  
(7) electric log no  
(yes or no)

(organization running log)  
(8) how well bottom plugged BP  
Valve

DRILLERS REMARKS:


CODED

MAY 20 1966

MISS. BO. OF WATER COMMISSIONERS

If well telescopes please sketch and show depths.

GROUND LEVEL

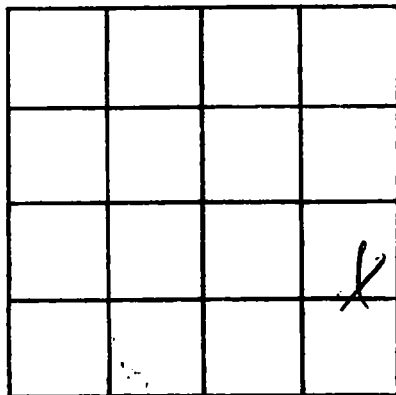

*Dring 5*  
SECTION 5

Please indicate well location X.

ADDITIONAL INFORMATION

If more than one screen,  
show locations of each on sketch.