

JACKSON

P 290.

4-1-63

MISSISSIPPI  
 BOARD OF WATER COMMISSIONERS  
 416 North State Street  
 Jackson, Mississippi 39201

*signed*

WATER WELL DRILLERS LOG

April 1 1963 Colville Water Supply Co. Inc. Jackson  
 date well completed firm name county well located

LANDOWNER: G C Colvin

description of formations encountered

from to

Escatawpa Miss  
 (mailing address)

clay	0	10
Sand	10	31
Soft Clay	31	45
Sand	45	90
Clay	90	153
Sand	153	189

WELL LOCATION:

sec 13 T 2 N R 6 E  
 Escatawpa  
 (distance) mile (direction) of (nearest town)

WELL PURPOSE: Home  
 (home, irrigation, municipal, industrial)

WELL COMPLETION DATA:

- (1) diameter (inches) 1 1/4
- (2) total depth (feet) 189
- (3) static water level (feet) 12 <sup>below</sup> / <sub>above</sub> top of ground.
- (4) casing Galv. 184  
 (material) (depth)  
 (size) if telescope see back.
- (5) screen 5 184  
 (length) (depth to top)  
 1/4 Brass  
 (size) (material)
- (6) pump (HP) (yield gpm)  
 (type power)
- (7) electric log No  
 (yes or no)  
 (organization running log)
- (8) how well bottom plugged BP Valve

*COPIED*

*COPIED*

MAR 20 1963

MISS. BOARD OF WATER COMMISSIONERS


MAY 27 1963

MISS. BOARD OF WATER COMMISSIONERS

DRILLERS REMARKS:

If well telescopes please sketch and show depths.

GROUND LEVEL

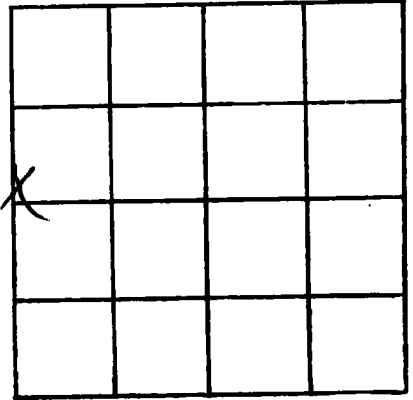

SECTION 13

Please indicate well location X.

ADDITIONAL INFORMATION

If more than one screen, show locations of each on sketch.