

JACKSON
P 292
7-21-64

MISSISSIPPI
BOARD OF WATER COMMISSIONERS
416 North State Street
Jackson, Mississippi 39201

CODER

CODE

WATER WELL DRILLERS LOG

July 21 1964 Cabille Water Supply Jackson
date well completed firm name county well located

LANDOWNER: Dr. S. T. T. Thompson

description of formations encountered

Moss Point, Miss
(mailing address)

	from	to
Clay	0	20
Sand	20	63
Clay	63	66
Sand	66	80

WELL LOCATION:
sec. 1 T. 4 N. R. 6 E. W. 1
Moss Point
(distance) miles (direction) of (nearest town)

Clay	80	90
Sand	90	110

WELL PURPOSE: Irrigation
(home, irrigation, municipal, industrial)

WELL COMPLETION DATA:

- (1) diameter (inches) 2"
- (2) total depth (feet) 80
- (3) static water level (feet) 22 1/2 (below) above top of ground
- (4) casing gal (material) 75 (depth)
- (size) If telescope see back.
- (5) screen 5 (length) 75 (depth to top)
- 2" (size) Stainless (material)
- (6) pump 1 (HP) 12 (yield gpm)
- elec (type power)
- (7) electric log no (yes or no)
- (organization running log)
- (8) how well bottom plugged B.P. Value

MAY 20 1968

MISS. BD. OF WATER COMMISSIONERS


MAY 27 1968

MISS. BOARD OF WATER COMMISSIONERS

DRILLERS REMARKS: Water at 110 was very salty!

If well telescopes please sketch and show depths.

GROUND LEVEL

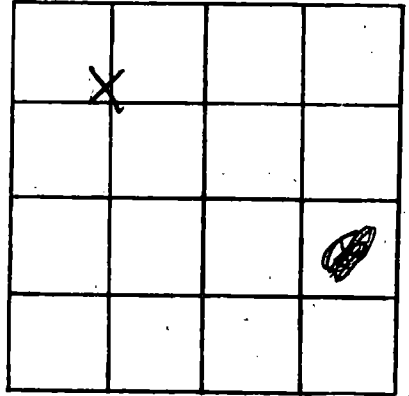

SECTION ~~1~~

Please indicate well location X.

ADDITIONAL INFORMATION

If more than one screen, show locations of each on sketch.