

Jackson
 P 294
 5-19-66

MISSISSIPPI
 BOARD OF WATER COMMISSIONERS
 416 North State Street
 Jackson, Mississippi 39201

CODED

WATER WELL DRILLERS LOG

May 19 1966 Abelle Water Supply Jackson
 d. well completed firm name county well located


LANDOWNER: <u>Harry Wright</u>	description of formations encountered	from	to
<u>11th St & Wash. Ave</u> (mailing address)	<u>8' rocks</u> <u>clay and clam shells</u> <u>clay</u> <u>sand</u>	<u>0</u> <u>22</u> <u>44</u> <u>74</u>	<u>22</u> <u>44</u> <u>74</u> <u>90</u>
WELL LOCATION: sec. <u>8</u> T. <u>8</u> N. R. <u>6</u> E _____ miles _____ of <u>Tuscaloosa</u> (distance) (direction) (nearest town)			
WELL PURPOSE: <u>water</u> (home, irrigation, municipal, industrial)			
WELL COMPLETION DATA:			
(1) diameter (inches) <u>2"</u>			
(2) total depth (feet) <u>90</u>			
(3) static water level (feet) <u>15</u> ^{below} above top of ground.			
(4) casing <u>galv</u> (material) (depth) (size) If telescope see back.			
(5) screen <u>5'</u> <u>85</u> (length) (depth, to top) <u>2"</u> <u>plastic</u> (size) (material)			
(6) pump _____ (HP) (yield gpm) (type power)			
(7) electric log <u>no</u> (yes or no)			
(organization running log)			
(8) how well bottom plugged <u>BPV only</u>			
DRILLERS REMARKS: <u>pump installed by owner</u>			

MAY 21 1969

MISS. BD. OF
 WATER COMM.

If well telescopes please sketch and show depths.

GROUND LEVEL

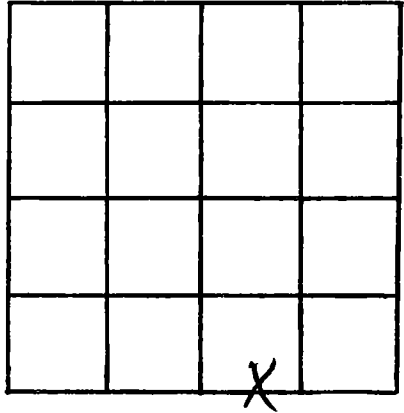

SECTION 8

Please indicate well location X.

ADDITIONAL INFORMATION

Lined area for additional information.

If more than one screen, show locations of each on sketch.