

Jackson
P295
6-4-66

MISSISSIPPI
BOARD OF WATER COMMISSIONERS
416 North State Street
Jackson, Mississippi 39201

CODED

WATER WELL DRILLERS LOG

June 4 1964 Colville Water Supply Jackson
date well completed firm name county well located

LANDOWNER: <u>Singing River</u> <u>Southeast Coast</u>	description of formations encountered	from	to
<u>Gautier, Miss</u> (mailing address)			
WELL LOCATION: <u>Srvg 9 T 8 N R 6 E</u> <u>3</u> miles <u>W</u> of <u>Pass.</u> (distance) (direction) (nearest town)	Clay	0	22
WELL PURPOSE: <u>cabins</u> (home, irrigation, municipal, industrial)	sand	22	308
WELL COMPLETION DATA:	Clay	308	380
(1) diameter (inches) <u>2"</u>	sand	380	415
(2) total depth (feet) <u>858</u>	Clay	415	512
(3) static water level (feet) <u>3</u> above ^{below} top of ground.	sand	512	550
(4) casing <u>galv</u> (material) (depth)	Clay	550	704
(size) if telescope see back.	quitty clay	704	780
(5) screen <u>10</u> <u>848</u> (length) (depth to top)	sand	780	858
<u>2"</u> <u>standars</u> (size) (material)			
(6) pump _____ (HP) (yield gpm)			
(type power)			
(7) electric log <u>no</u> (yes or no)			
(organization running log)			
(8) how well bottom plugged <u>BPA Valve</u>			
DRILLERS REMARKS: <u>pump installed by owner</u>			


CODED

APR 21 1969

MISS. BD. OF
WATER COMM.

If well telescopes please
sketch and show depths.

GROUND LEVEL

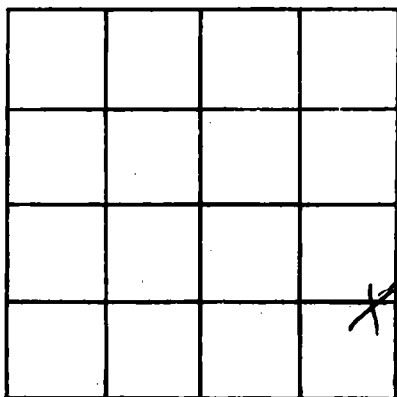

Imag SECTION 9

Please indicate well location X.

ADDITIONAL INFORMATION

A series of horizontal lines for writing additional information.

If more than one screen,
show locations of each on sketch.