

Jackson  
 P300  
 4-3-67

MISSISSIPPI  
 BOARD OF WATER COMMISSIONERS  
 416 North State Street  
 Jackson, Mississippi 39201

CODED

WATER WELL DRILLERS LOG

April 3 1967 Charles Water Sup Jackson  
 well completed firm name county well located


LANDOWNER: <u>SW Smith</u>	description of formations encountered	from	to
<u>Lawrence Min</u> (mailing address)	<u>Silica</u>	0	22
WELL LOCATION: sec. <u>11</u> T. <u>7</u> N. R. <u>6</u> E. <u>4</u> miles <u>North</u> of <u>MP</u> (distance) (direction) (nearest town)	<u>soft clay</u>	22	44
WELL PURPOSE: <u>home</u> (home, irrigation, municipal, industrial)	<u>sand</u>	44	171
WELL COMPLETION DATA: (1) diameter (inches) <u>2"</u>	<u>clay</u>	171	523
(2) total depth (feet) <u>533</u>	<u>sand</u>	523	533
(3) static water level (feet) <u>8</u> <u>below</u> <u>above</u> top of ground.			
(4) casing <u>galv</u> , _____, (material) (depth)  (size) If telescope see back.			
(5) screen <u>5</u> , <u>528</u> (length) (depth to top)			
_____ , _____ (size) (material)			
(6) pump <u>1/2</u> , <u>7</u> (HP) (yield gpm)			
_____ <u>etc</u> (type power)			
(7) electric log <u>no</u> (yes or no)			
_____ <u>BP Valve</u> (organization running log)			
DRILLERS REMARKS:			

APR 21 1967

MISS. BD. OF  
 WATER COMM.

If well telescopes please sketch and show depths.

GROUND LEVEL

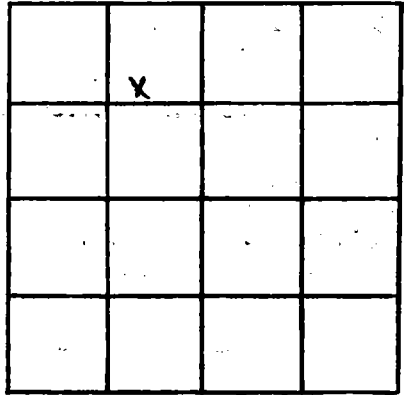

SECTION 11

Please indicate well location X.

ADDITIONAL INFORMATION

If more than one screen, show locations of each on sketch.