

Jackson  
P302  
7-21-67

MISSISSIPPI  
BOARD OF WATER COMMISSIONERS  
416 North State Street  
Jackson, Mississippi 39201

CODED

WATER WELL DRILLERS LOG

July 21 1967 Abilla Water Sys Jackson  
 days well completed firm name county well located

LANDOWNER: <u>Merdy Johnson</u>	description of formations encountered	from	to
<u>320 S. Pass. St.</u>	<u>Sand</u>	<u>0</u>	<u>12</u>
<u>Pascagoula Miss</u> (mailing address)	<u>clay</u>	<u>12</u>	<u>54</u>
WELL LOCATION:	<u>sand</u>	<u>24</u>	<u>87</u>
sec. <u>6</u> T. <u>8</u> N. R. <u>6</u> E. (distance) miles (direction) of <u>Pascagoula</u> (nearest town)			
WELL PURPOSE: <u>irr</u> (home, irrigation, municipal, industrial)			
WELL COMPLETION DATA:			
(1) diameter (inches) <u>2"</u>			
(2) total depth (feet) <u>87</u>			
(3) static water level (feet) <u>13</u> <u>(below)</u> top of ground.			
(4) casing <u>galv</u> (material) (depth)			
(size) If telescope see back.			
(5) screen <u>5</u> <u>87</u> (length) (depth to top)			
<u>2"</u> <u>plastic</u> (size) (material)			
(6) pump <u>1 1/2</u> <u>20</u> (HP) (yield gpm)			
<u>elec</u> (type power)			
(7) electric log <u>no</u> (yes or no)			
(organization running log)			
(8) how well bottom plugged <u>BP Valve</u>			
DRILLERS REMARKS:			


CODED

APR 21 1969

MISS. BD. OF  
WATER COMMISSIONERS

If well telescopes please  
sketch and show depths.

GROUND LEVEL

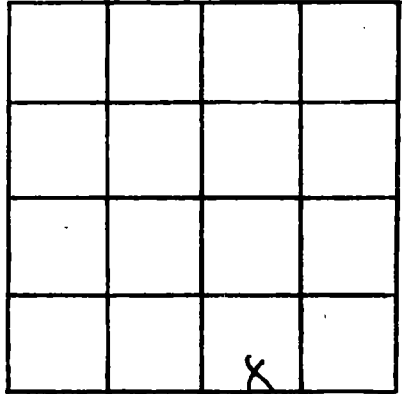

SECTION 6

Please indicate well location X.

**ADDITIONAL INFORMATION**

---

---

If more than one screen,  
show locations of each on sketch.