

Jackson
 P 303
 7-24-67

MISSISSIPPI
 BOARD OF WATER COMMISSIONERS
 416 North State Street
 Jackson, Mississippi 39201

CODED

WATER WELL DRILLERS LOG

July 24 1967 White Water Sng Jackson
 d. well completed firm name county well located

LANDOWNER: <u>Calson</u>	description of formations encountered	from	to
<u>Bolding South Market</u>			
<u>Paragoula Min</u> (mailing address)	<u>Sand & silt clay sand</u>	<u>0 15 35</u>	<u>15 35 66</u>
WELL LOCATION:			
sec. <u>8</u> T. <u>8</u> N R. <u>6</u> E (distance) miles (direction) of <u>Paragoula</u> (nearest town)			
WELL PURPOSE: <u>LD</u> (home, irrigation, municipal, industrial)			
WELL COMPLETION DATA:			
(1) diameter (inches) <u>2</u>			
(2) total depth (feet) <u>66</u>			
(3) static water level (feet) <u>13</u> ^{below} above top of ground.			
(4) casing <u>galv</u> (material) (depth) _____ (size) _____ if telescope see back.			
(5) screen <u>5</u> (length) <u>61</u> (depth to top)			
<u>2</u> (size) <u>plastic</u> (material)			
(6) pump <u>1/2</u> (HP) <u>6</u> (yield gpm)			
<u>electric</u> (type power)			
(7) electric log <u>no</u> (yes or no)			
_____ (organization running log)			
(8) how well bottom plugged <u>SP Water</u>			
DRILLERS REMARKS:			


CODED

APR 21 1969

MISS. Bd. of
 WATER COMM.

If well telescopes please sketch and show depths.

GROUND LEVEL

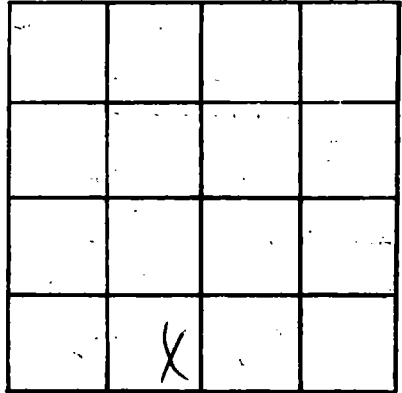

SECTION 8

Please indicate well location X.

ADDITIONAL INFORMATION

If more than one screen, show locations of each on sketch.