

Jackson
 P 305
 9-26-67

MISSISSIPPI
 BOARD OF WATER COMMISSIONERS
 416 North State Street
 Jackson, Mississippi 39201

CODED

WATER WELL DRILLERS LOG

9/26 1967 Calista Water Supply Jackson
 well completed firm name county well located


LANDOWNER: <u>Mrs. Myra Ware</u>	description of formations encountered	from	to
<u>Cooper Sub. (Coastalway)</u> (mailing address)	<u>clay</u> <u>sand</u>	<u>0</u> <u>62</u>	<u>62</u> <u>78</u>
WELL LOCATION: sec. <u>2</u> T. <u>7</u> N. R. <u>6</u> E. <u>3 1/2</u> miles <u>N.</u> of <u>MP</u> (distance) (direction) (nearest town)			
WELL PURPOSE: <u>home</u> (home, irrigation, municipal, industrial)			
WELL COMPLETION DATA: (1) diameter (inches) <u>2</u> (2) total depth (feet) <u>78</u> (3) static water level (feet) <u>11</u> <u>below</u> above top of ground. (4) casing <u>galv.</u> (material), (depth) _____ _____ (size) If telescope see back. (5) screen <u>4</u> _____ <u>74</u> _____ (length) (depth to top) <u>2</u> _____ <u>plastic</u> _____ (size) (material) (6) pump <u>1/2</u> _____ <u>7</u> _____ (HP) (yield gpm) <u>elc</u> _____ (type power) (7) electric log <u>no</u> _____ (yes or no) _____ (organization running log) (8) how well bottom plugged <u>BP Value</u>			
DRILLERS REMARKS: _____			

APR 21 1969

MISS. BD. OF
 WATER COMM.

If well telescopes please sketch and show depths.

GROUND LEVEL

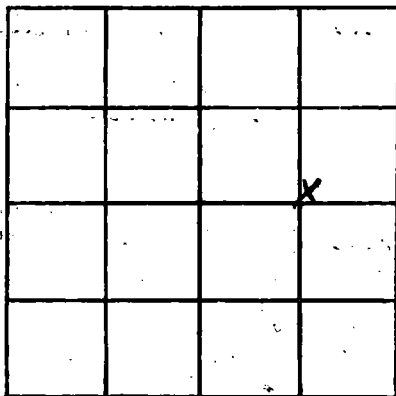

SECTION 2

Please indicate well location X.

ADDITIONAL INFORMATION

Lined area for additional information.

If more than one screen, show locations of each on sketch.