

CODED

P306

3651 4346

WATER WELL DRILLERS LOG

Date: Jan. 6, 1961, Driller: L. L. Harland County: Jackson
(Name)

(1) Owner of Land: Mr. ~~Harland~~ Haydell
(Name)
Escatawapa, Miss.
(Address)

(2) Location: 1/4, 1/4, Sec. 12 T 7 R 6
(distance) (direction) (Nearest Town)

(3) Topography: Domestic
(Hilly) (Flat) (Level)

(4) Purpose of Well: Domestic
(Domestic Irrigation Municipal, Industrial, Other)

Description & Color of Materials Sand, Clay, Red Clay, Shell, etc.	Thick- ness Feet	Depth Feet
21' Clay		
18' Sand 3' mud		
10' mud 10' sand 1' mud		
10' sand 11' mud		
19' fine gravel 2' mud		
2' mud		
21' "		
21' sand + mud streaks		
16' sand 5' mud		
21' mud		
21' " + sand streaks		
18' " 3' shale 1' mud		
14' sand + mud streaks		
7' mud		
21' "		
10' mud 5' sand 7' mud		
11' " 10' "		
16' sand (Good)		

Information upon completion of well:

(1) Diameter 2 inches.

(2) Total Depth 252 feet.

(3) Water Level 6 feet below top of ground.

(4) Cased to _____, Size _____

(5) Screen: Size .08, Length 10'


(6) Were any formations sealed against pollution?
_____ yes, _____ no.

If YES depth of formation _____

Why _____

Drillers Remarks: _____

CODED

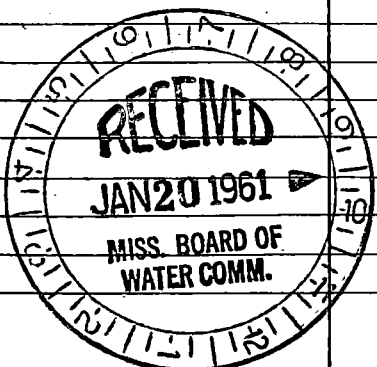

(Use Back Side)

Well No.

352'

