

CODED

MISSISSIPPI
BOARD OF WATER COMMISSIONERS
416 North State Street
Jackson, Mississippi 39201

WATER WELL DRILLERS LOG

Jackson
P 307
10-8-69

Oct 8 1969 L. L. Garland water wells Jackson
date well completed firm name county well located

LANDOWNER:

W. H. Griffin
Box 11, Gautier, Miss
(mailing address)

description of formations encountered

from to

WELL LOCATION:

sec. 3 T 7 N R 6 E
3 blocks north of Gautier
(distance) (direction) (nearest town)

WELL PURPOSE:

home
(home, irrigation, municipal, industrial)

WELL COMPLETION DATA:

- (1) diameter (inches) 2"
- (2) total depth (feet) 1040
- (3) static water level (feet) _____ below above top of ground.
- (4) casing steel, 1030, (material) (depth)
2 (size) if telescope see back.
- (5) screen 10 ft, 1030 (length) (depth to top)
8 gauge, stainless steel (size) (material)
- (6) pump 1/2 hp, 750 gal per hr (HP) (yield gpm)
electric (type power)
- (7) electric log NO (yes or no)

(organization running log)

(8) how well bottom plugged Wash Valve

OCT 15 1969


MISS. BD. OF
WATER COMM.

DRILLERS REMARKS:

40 ft water
bearing sand

If well telescopes please sketch and show depths.

GROUND LEVEL

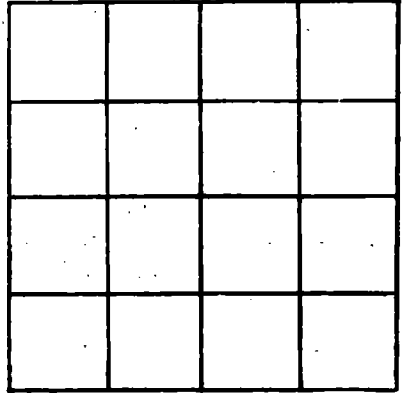

SECTION _____

Please indicate well location X.

ADDITIONAL INFORMATION

If more than one screen, show locations of each on sketch.