

MISSISSIPPI
BOARD OF WATER COMMISSIONERS
416 North State Street
Jackson, Mississippi 39201

Jackson
P 308
7-11-68
MS-6W-01731

WATER WELL DRILLERS LOG

July 11 1968 *Cobville Water Supply* Jackson
date well completed firm name county well located

LANDOWNER: *Concrete Products*

description of formations encountered	from	to
<i>soft blue clay</i>	0	30
<i>sand</i>	30	93
<i>soft blue clay</i>	93	125
<i>sand</i>	125	132
<i>clay</i>	132	142
<i>sand</i>	142	186
<i>clay</i>	186	205
<i>sand</i>	205	325

and Supply Co. Inc.
Passagoula Miss
(mailing address)

WELL LOCATION:

sec. 2 T. 8 N. R. 6 E
across hwy from Passagoula
(distance) miles (direction) of (nearest town)

WELL PURPOSE: *domest. clust*
(home, irrigation, municipal, industrial)

WELL COMPLETION DATA:

- (1) diameter (inches) 6
- (2) total depth (feet) 325
- (3) static water level (feet) 31 ^(below) above top of ground
- (4) casing steel, 295,
(material) (depth)
6 If telescope see back.
(size)
- (5) screen 30, 295
(length) (depth to top)
6" stainless
(size) (material)
- (6) pump 20 250
(HP) (yield gpm)
- elec
(type power)
- (7) electric log no
(yes or no)

(organization running log)

(8) how well bottom plugged BP valve


JAN 8 1970

MISS B...
WA...

DRILLERS REMARKS: *action*
unmarked on our maps.

If well telescopes please sketch and show depths.

GROUND LEVEL

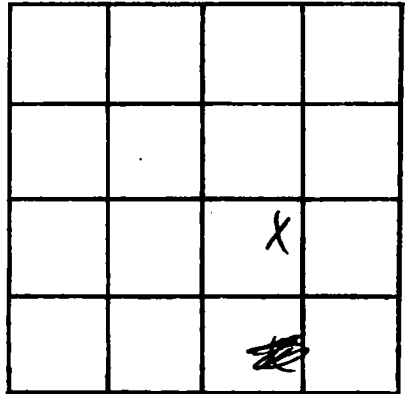

SECTION *Unknown*

Please indicate well location X.

ADDITIONAL INFORMATION

If more than one screen, show locations of each on sketch.