

**MISSISSIPPI  
BOARD OF WATER COMMISSIONERS**  
416 North State Street  
Jackson, Mississippi 39201

CODED

**WATER WELL DRILLERS LOG**


Jackson  
P 311  
10-29-68

Oct 29 1968 Colville Water Supply Jackson  
date well completed firm name county well located

LANDOWNER: <u>Mrs. Anne</u>	description of formations encountered	from	to
<u>May Sibley</u>	<u>Clay</u>	<u>0</u>	<u>22</u>
<u>Gautier, Miss</u> (mailing address)	<u>sand</u>	<u>22</u>	<u>170</u>
<b>WELL LOCATION:</b>	<u>Clay</u>	<u>170</u>	<u>264</u>
sec. <u>9</u> - T. <u>8</u> N. R. <u>6</u> E	<u>sand</u>	<u>264</u>	<u>304</u>
<u>6</u> miles <u>West</u> of <u>Precon</u>	<u>Clay</u>	<u>304</u>	<u>394</u>
(distance) (direction) (nearest town)	<u>sand</u>	<u>394</u>	<u>426</u>
<b>WELL PURPOSE:</b> <u>home</u> (home, irrigation, municipal, industrial)			
<b>WELL COMPLETION DATA:</b>			
(1) diameter (inches) <u>2</u>			
(2) total depth (feet) <u>426</u>			
(3) static water level (feet) <u>4</u> <u>below</u> top of ground.			
(4) casing <u>galv</u> (material), (depth)			
(size) If telescope see back.			
(5) screen <u>5'</u> <u>421</u> (length) (depth to top)			
<u>2</u> (size) <u>stainless</u> (material)			
(6) pump <u>1/2</u> (HP) <u>4</u> (yield gpm)			
<u>elec</u> (type power)			
(7) electric log <u>no</u> (yes or no)			
(organization running log)			
(8) how well bottom plugged <u>BP Valve</u>			
<b>DRILLERS REMARKS:</b>			
	<b>JAN 8 1970</b>		
	MIST. I.D. OF WATER COMM.		

If well telescopes please sketch and show depths.

GROUND LEVEL

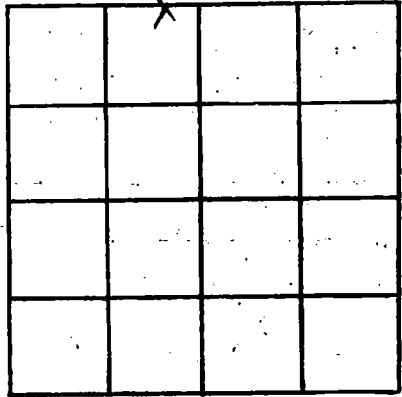

SECTION 9

Please indicate well location X.

ADDITIONAL INFORMATION

If more than one screen, show locations of each on sketch.