

Jackson
 P312
 12-13-69

MISSISSIPPI
 BOARD OF WATER COMMISSIONERS
 416 North State Street
 Jackson, Mississippi 39201

CODED

WATER WELL DRILLERS LOG

Dec 13 1969 Colville Water Supply Jackson
 date well completed firm name county well located


LANDOWNER: Stan Peterson	description of formations encountered	from	to
Gautier (mailing address)	Clay mud	2	78
WELL LOCATION: sec. 9 T. 6 N. R. 6 E. 4 miles West of Parc (distance) (direction) (nearest town)			
WELL PURPOSE: Home (home, irrigation, municipal, industrial)			
WELL COMPLETION DATA: (1) diameter (inches) 2 (2) total depth (feet) 315 (3) static water level (feet) 16 below top of ground. (4) casing galv (material), (depth), (size) if telescope see back. (5) screen 5' 310 (length) (depth to top) 2 stainless (size) (material) (6) pump (HP) (yield gpm) (type power) (7) electric log NO (yes or no) (organization running log) (8) how well bottom plugged B.P. Kelly			
DRILLERS REMARKS: pump installed by owner			

JAN - 8 1970

MISS. BD. OF
 WATER COM.

If well telescopes please sketch and show depths.

GROUND LEVEL

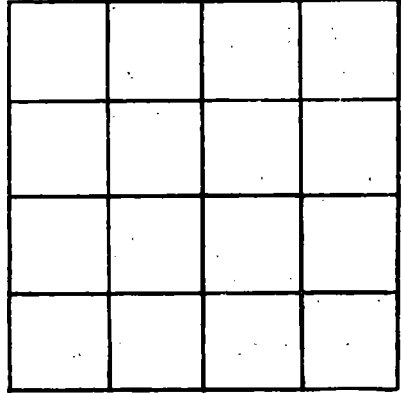

Irregular section
SECTION

Please indicate well location X.

ADDITIONAL INFORMATION

If more than one screen, show locations of each on sketch.