

MISSISSIPPI  
BOARD OF WATER COMMISSIONERS  
416 North State Street  
Jackson, Mississippi 39201

**CODED**

**WATER WELL DRILLERS LOG**

JACKSON  
P320  
6-6-70

6-6 1970 Coast Water Well Service Jackson  
date well completed firm name county well located

LANDOWNER: Henry Lee  
Deatrice, Miss.

description of formations encountered	from	to
	Surface Soil	0

(mailing address)

WELL LOCATION:  
sec. 31 T. 7 S. R. 6  
4.5 miles W of Josopark  
(distance) (direction) (nearest town)

Sand med. to coarse	18	68
Blue Clay	68	84
Sand Fine to med.	84	120
Blue Clay	120	220

WELL PURPOSE: Home  
(home, irrigation, municipal, industrial)

Sand Med to coarse	220	290
--------------------	-----	-----

WELL COMPLETION DATA:

- (1) diameter (inches) 2"
- (2) total depth (feet) 1039
- (3) static water level (feet) 6 below top of ground.
- (4) casing Black (material), 1029 (depth)
- 2" (size) if telescope see back.
- (5) screen 10' (length), 1029 (depth to top)
- 2" (size), Stainless Boring (material)
- (6) pump 1 (HP), 12 (yield gpm)
- elec. (type power)
- (7) electric log NO (yes or no)

Blue Clay	290	400
Fine Sand	400	420
Blue Clay + Shank Sand	420	730
Sand - Real Fine	730	742
Blue Clay	742	1015
Sand - Fine to med.	1015	1039

**CODED**

SEP 18 1970

(organization running log)


(8) how well bottom plugged  
Backwash Valve

M.S.S. BD. OF  
WATER COMM.

DRILLERS REMARKS:

If well telescopes please sketch and show depths.

GROUND LEVEL

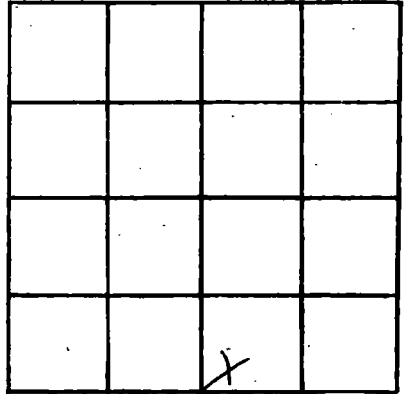

SECTION 31

Please indicate well location X.

ADDITIONAL INFORMATION

If more than one screen, show locations of each on sketch.