

JACKSON

P321

7-1-70

MISSISSIPPI BOARD OF WATER COMMISSIONERS
416 North State Street
Jackson, Mississippi 39201

CODED

WATER WELL DRILLERS LOG

7-1
date well completed

1970 Coast Water Well Service
firm name

Jackson
county well located

LANDOWNER:

E.B. Smith

Latimer, Miss.

(mailing address)

description of formations encountered

from

to

Surface soil

0

12

Sand w/ thin streaks of clay

12

260

Blue clay

260

366

Sand - fine to med

366

396

WELL LOCATION:

sec 26 T 8

R 6

4.5 miles

W

of Osageville

(distance)

(direction)

(nearest town)

WELL PURPOSE:

Home

(home, irrigation, municipal, industrial)

WELL COMPLETION DATA:

(1) diameter (inches)

2"

(2) total depth (feet)

396'

(3) static water level (feet)

19

below above top of ground.

(4) casing

galv. (material)

386' (depth)

2" (size)

If telescope see back.

(5) screen

10 (length)

386' (depth to top)

2" (size)

Stainless Steel (material)

(6) pump

1/2 (HP)

8 (yield gpm)

elec. (type power)

(7) electric log

no (yes or no)

(organization running log)

(8) how well bottom plugged

Backpack (value)

DRILLERS REMARKS:


CODED

SEP 18 1970

MISS. BD. OF WATER COMM.

If well telescopes please sketch and show depths.

GROUND LEVEL

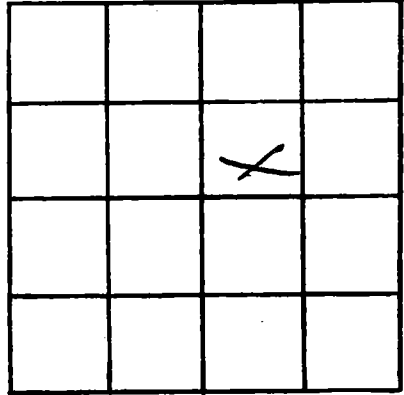

SECTION 26

Please indicate well location X.

ADDITIONAL INFORMATION

Lined area for additional information.

If more than one screen, show locations of each on sketch.