

JACKSON
 P326
 10-14-70

MISSISSIPPI
 BOARD OF WATER COMMISSIONERS
 416 North State Street
 Jackson, Mississippi 39201

CODED

WATER WELL DRILLERS LOG

10-14 1970 date well completed
 220 Coast Water Well Service firm name
 Jackson county well located

LANDOWNER: Fili's Restaurant
Sauter, Miss.
 (mailing address)

description of formations encountered	from	to
top soil + clay	0	42
Sand - med - coarse	42	119
blue clay	119	220
Sand - med - coarse	220	262

WELL LOCATION:
 sec 31 T 7 N R 6 E
5
4 miles W of Pascagoula
 (distance) (direction) (nearest town)

WELL PURPOSE: Restaurant
 (home, irrigation, municipal, industrial)

WELL COMPLETION DATA:

(1) diameter (inches) 4"

(2) total depth (feet) 262'

(3) static water level (feet) 21 below above top of ground.

(4) casing P.V.C. 252'
 (material) (depth)
4"
 (size) if telescope see back.

(5) screen 10' 252'
 (length) (depth to top)
4" P.V.C.
 (size) (material)

(6) pump 1 1/2 36
 (HP) (yield gpm)
elec.
 (type power)

(7) electric log NO
 (yes or no)

(organization running log)

(8) how well bottom plugged machined valve

CODED


JAN 25 1971

MISS. BD. OF
 WATER COM.

DRILLERS REMARKS:

If well telescopes please sketch and show depths.

GROUND LEVEL

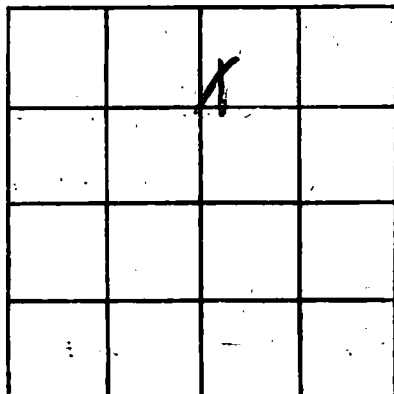

SECTION 31

Please indicate well location X.

ADDITIONAL INFORMATION

If more than one screen, show locations of each on sketch.