

CODED

FEB 16 1971

MISS. BD. OF WATER COMM.

JACKSON
P329
12-21-70

MISSISSIPPI
BOARD OF WATER COMMISSIONERS
416 North State Street
Jackson, Mississippi 39201

WATER WELL DRILLERS LOG

12-21-70 date well completed 770 Coast Water Well Serv. firm name Jackson county well located

LANDOWNER William B. Daisey
2903 Larchmont
Jacquesville Miss.
(mailing address)

description of formations encountered	from	to
top soil + clay	0	63
sand - med to coarse	63	119

WELL LOCATION:
sec. 9 T. 8 N. R. 6 E
IN GAUTIER, MISS.
miles (distance) of (direction) of (nearest town)

blue clay	119	219
sand - fine, med + coarse	219	327
blue clay	327	400

WELL PURPOSE: home
(home, irrigation, municipal, industrial)

very fine sand	400	417
----------------	-----	-----

WELL COMPLETION DATA:

- (1) diameter (inches) 2"
- (2) total depth (feet) 735'
- (3) static water level (feet) 22 below top of ground.
- (4) casing galv. (material) 725' (depth)
2" (size) If telescope see back.
- (5) screen 10' (length) 725' (depth to top)
2" (size) Staircase (material)
- (6) pump 1 (HP) 15 (yield gpm)
elec. (type power)
- (7) electric log NO (yes or no)

blue clay + sand streaks	417	690
sand - fine to med.	690	735

CODED


(organization running log)

(8) how well bottom plugged backwash valve

DRILLERS REMARKS:

If well telescopes please sketch and show depths.

GROUND LEVEL

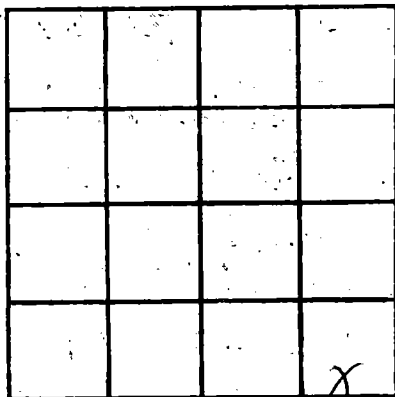

SECTION 9

Please indicate well location X.

ADDITIONAL INFORMATION

If more than one screen,
show locations of each on sketch.