

JACKSON
P 330
1-3-71

MISSISSIPPI
BOARD OF WATER COMMISSIONERS
416 North State Street
Jackson, Mississippi 39201

CODED

FEB 16 1971

MISS. BD. OF
WATER COMM.

WATER WELL DRILLERS LOG

1-3
date well completed

1971 *Coast Water Well Serv.*
firm name

Jackson
county well located

LANDOWNER *Jack Swiman*
Star Route 2
Montee, Miss.
(mailing address)

description of fomations encountered	from	to
<i>top soil & clay</i>	0	42
<i>sand fine to med.</i>	42	240
<i>blue clay + sand streaks</i>	240	800
<i>sand - fine to med.</i>	800	829

WELL LOCATION:
sec. 12 T 7 S R. 46 E W
5 1/2 miles NW of Procopula
(distance) (direction) (nearest town)

WELL PURPOSE: home
(home, irrigation, municipal, industrial)

WELL COMPLETION DATA:

- (1) diameter (inches) 2"
- (2) total depth (feet) 829'
- (3) static water level (feet) 21 below above top of ground.
- (4) casing galv. 819'
(material) (depth)
2"
(size) If telescope see back.
- (5) screen 10' 819'
(length) (depth to top)
2" stainless steel
(size) (material)
- (6) pump 1 9
(HP) (yield gpm)
elec
(type power)
- (7) electric log no.
(yes or no)

CODED


(organization running log)

(8) how well bottom plugged
Hardbottom Valve

DRILLERS REMARKS:

If well telescopes please sketch and show depths.

GROUND LEVEL

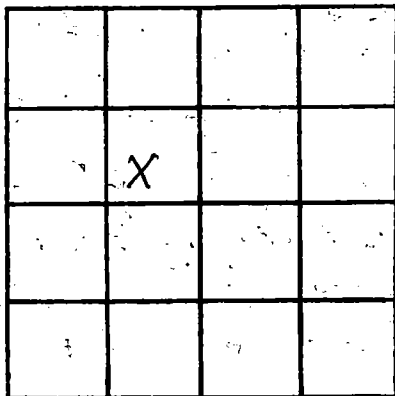

SECTION 12

Please indicate well location X.

ADDITIONAL INFORMATION

If more than one screen, show locations of each on sketch.