

P. 331

2497 3635

**WATER WELL DRILLERS LOG**

3-22-61

Date: 3-22, 1961, Driller: C.T. Switzger County Jackson  
(Name)

(1) Owner of Land: Dolphus Griffin  
(Name)  
Antier, Mrs.  
(Address)

(2) Location: 1/4, 1/4, Sec. 8 T7 R6,  
\_\_\_\_\_ miles \_\_\_\_\_ of \_\_\_\_\_  
(distance) (direction) (Nearest Town)

(3) Topography:  (Hilly)  (Flat)  (Level)

(4) Purpose of Well: Domestic  
(Domestic Irrigation  
Municipal, Industrial, Other)

Description & Color of Materials Sand, Clay, Red Clay, Shell, etc.	Thick- ness Feet	Depth Feet
<u>sand</u>	<u>0</u>	<u>10</u>
<u>Clay</u>	<u>50</u>	<u>60</u>
<u>Hard sand</u>	<u>48</u>	<u>101</u>
<u>sand</u>	<u>15</u>	<u>116</u>
<u>Clay</u>	<u>5</u>	<u>121</u>
<u>sand</u>	<u>42</u>	<u>161</u>
<u>Clay</u>	<u>36</u>	<u>197</u>
<u>sand</u>	<u>26</u>	<u>223</u>

Information upon completion of well:

(1) Diameter 2" inches.

(2) Total Depth 273 feet.

(3) Water Level 25' feet below top of ground.

(4) Cased to 273, Size 2"

(5) Screen: Size 2", Length 10'

(6) Were any formations sealed against pollution?  
 yes, \_\_\_\_\_ no.

If YES depth of formation 10 FT.


Why Health Dept. Requirement

Drillers Remarks: \_\_\_\_\_

\_\_\_\_\_

\_\_\_\_\_

**CODED**

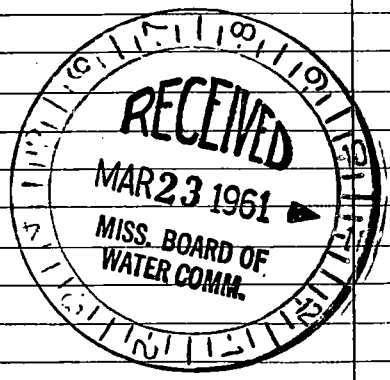

(Use Back Side)

Well No.

