

P333 4386

WATER WELL DRILLERS LOG

**CODED**

4-20-62

Date: 4-20, 1962, Driller: C. I. SWITZER WELL CO. County: Jackson

(Name)

(1) Owner of Land: Bernie Little  
(Name)

Sauter, Miss.  
(Address)

(2) Location: 1/4, 1/4, Sec. 1 T8 R6  
\_\_\_\_\_ miles \_\_\_\_\_ of \_\_\_\_\_  
(distance) (direction) (Nearest Town)

(3) Topography:  (Hilly)  (Flat)  (Level)

(4) Purpose of Well: Domestic  
(Domestic Irrigation, Municipal, Industrial, Other)

Description & Color of Materials Sand, Clay, Red Clay, Shell, etc.	Thick- ness Feet	Depth Feet
Clay	00	15
Sand	15	24
Sand s&cks	24	44
Sand	44	91
Clay	91	192
Sand	192	225
Sand	225	308
Sand, s&cks	308	328
Sand	328	338
Clay	338	368
Sand	368	378
Clay	378	463
Clay w/ 1" rock	463	471
Shell & Sand s&cks	471	491
Sand s&cks	491	512
Shell & sand s&cks	512	532
Clay	532	572
Clay & sand s&cks	572	613
Sand, fine	613	633
Sand, good	633	653
Sand	653	733
Clay	733	735

Information upon completion of well:

(1) Diameter 2 inches.

(2) Total Depth 735 feet.

(3) Water Level 3.06 + feet below top of ground.

(4) Cased to 735, Size 2"


(5) Screen: Size 2", Length 30'

(6) Were any formations sealed against pollution?  
 yes,  no.

If YES depth of formation \_\_\_\_\_

Why Health Dept. Requirement

Drillers Remarks: \_\_\_\_\_

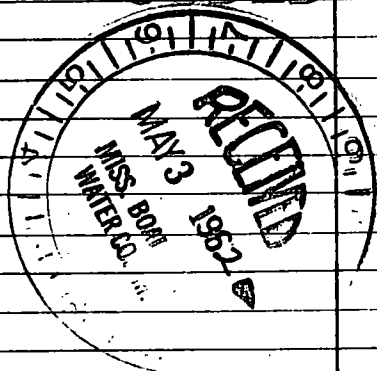

(Use Back Side)

Well No.

