

P334

8-7-62

3682

WATER WELL DRILLERS LOG

CODED

C. T. SWITZER WELL CO.

Date: 8-7, 1962, Driller: _____ County Jackson

(Name)

(1) Owner of Land: Donna Hancock

(Name)

old Highway 90, Hattiesburg, Miss.

(Address)

(2) Location: _____ 1/4, _____ 1/4, Sec. 31 T. 7 R. 6

_____ miles _____ of _____

(distance) (direction) (Nearest Town)

(3) Topography: _____

(Hilly) (Flat) (Level)

(4) Purpose of Well: Domestic

(Domestic Irrigation
Municipal, Industrial, Other)

Description & Color of Materials Sand, Clay, Red Clay, Shell, etc.	Thick- ness Feet	Depth Feet
Clay	00	40
Sand, good	40	100
Clay	100	120
Sand, fair	120	140
Sand, good	140	160
Clay	160	195
Sand	195	200
Sand, fair	200	220
Sand, good	220	270

Information upon completion of well:

(1) Diameter 2 inches.

(2) Total Depth 270' feet.

(3) Water Level 24' feet below top of ground.

(4) Cased to 270', Size 2"

(5) Screen: Size 2", Length 10'

(6) Were any formations sealed against pollution?


yes, _____ no.

If YES depth of formation _____

Why Health Dept. Requirement

Drillers Remarks: _____

CODED

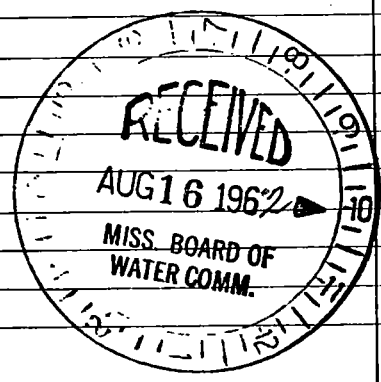

(Use Back Side)

Well No.

1000

1000

