

JACKSON MISSISSIPPI BOARD OF WATER COMMISSIONERS

P335

2786 4249

WATER WELL DRILLERS LOG

**CODED**

9-7-62

Date: 9/7, 19 62 Driller: Flin Colville County Jackson  
 (Name)

(1) Owner of Land: G.H. Martin  
 (Name)  
Ecatawpa, Miss  
 (Address)

(2) Location: 1/4, 1/4, Sec. 10 T. 7 R. 6  
       miles        of         
 (distance) (direction) (Nearest Town)

(3) Topography: flat  
 (Hilly) (Flat) (Level)

(4) Purpose of Well: domestic  
 (Domestic Irrigation  
 Municipal, Industrial, Other)

Description & Color of Materials Sand, Clay, Red Clay, Shell, etc.	Thick- ness Feet	Depth Feet
0-21 clay		
21-42 clay		
42-63 sand & gravel		
63-84 sand & gravel		
84-100 sand & gravel		
100-105 clay		
105-126 clay		
126-144 clay		
144-147 sand		
147-168 sand		
168-178 sand		
178-189 clay		
189-210 clay		
210-231 clay		
231-247 clay		
247-252 sand		
252-256 sand		
256-273 clay		
273-294 brindle clay		
294-315 - yellow clay		
315-320 brindle clay		
320-336 sand		
336-346 sand		
TD		

**CODED**

Information upon completion of well:

(1) Diameter 1 1/4 inches.

(2) Total Depth 346 feet.

(3) Water Level 7' feet below top of ground.

(4) Cased to       , Size       .


(5) Screen: Size 1 1/4, Length 10'.

(6) Were any formations sealed against pollution?  
       yes, X no.

If YES depth of formation       

Why       

Drillers Remarks:       

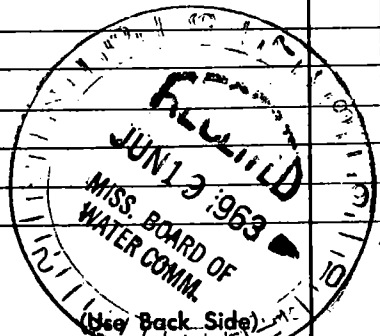

Well No. 175

