

CODED

JACKSON WATER WELL DRILLERS LOG

3620 4024

C. I. SWITZER WELL CO.

Date: 3-22-64, 1964

Driller:

County: Jackson

3-22-64

(Name)

(1) Owner of Land: J. D. Wilcox
 (Name)
So. Venable, Miss.
 (Address)

(2) Location: 7 7 6
 1/4, 1/4, Sec. T R
 _____ miles _____ of _____
 (distance) (direction) (Nearest Town)

(3) Topography: ✓
 (Hilly) (Flat) (Level)

(4) Purpose of Well: Domestic
 (Domestic Irrigation
 Municipal, Industrial, Other)

Description & Color of Materials Sand, Clay, Red Clay, Shell, etc.	Thick- ness Feet	Depth Feet
<u>sand & clay</u>	<u>00</u>	<u>24</u>
<u>sandy clay</u>	<u>24</u>	<u>45</u>
<u>clay</u>	<u>45</u>	<u>79</u>
<u>rock</u>	<u>79</u>	<u>80</u>
<u>clay</u>	<u>80</u>	<u>105</u>
<u>sand</u>	<u>105</u>	<u>154</u>
<u>sand & gravel</u>	<u>154</u>	<u>168</u>
<u>clay</u>	<u>168</u>	<u>215</u>
<u>sand</u>	<u>215</u>	<u>239</u>
<u>sand & clay mixed</u>	<u>239</u>	<u>240</u>
<u>sand, fine</u>	<u>240</u>	<u>252</u>
<u>sand</u>	<u>252</u>	<u>296</u>
<u>clay</u>	<u>296</u>	<u>323</u>
<u>sand</u>	<u>323</u>	<u>380</u>

Information upon completion of well:

(1) Diameter: 3 1/2" inches.

(2) Total Depth: 381' feet.

(3) Water Level: 32' 8" feet below top of ground.

(4) Cased to 381', Size 2x3"

(5) Screen: Size 2", Length 10'


(6) Were any formations sealed against pollution?
✓ yes, _____ no.

CODED

If YES depth of formation _____

Why: Health Dept. requirement

Drillers Remarks: _____

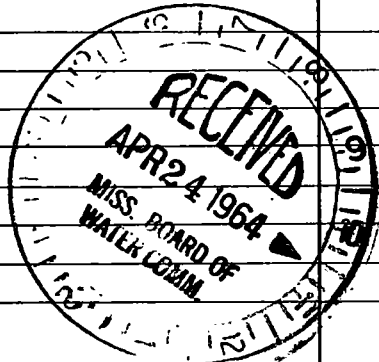

(Use Back Side)

Well No.

1111

