

Jackson
 P340
 7-67

MISSISSIPPI
 BOARD OF WATER COMMISSIONERS
 416 North State Street
 1744 Jackson, Mississippi 39201

CODED

WATER WELL DRILLERS LOG

7-28 1967 Coast Water Well Dr. Jackson
 date well completed firm name county well located

LANDOWNER: Robert Chapin
665 Shepard Ave
Pascagoula, Miss.
 (mailing address)


description of formations encountered	from	to
<u>Red + Blue Clay</u>	<u>0</u>	<u>40</u>
<u>Sand + gravel</u>	<u>40</u>	<u>68</u>

WELL LOCATION:
 sec. 12 T. 8 N. R. 6 E.
 miles of Pascagoula
 (distance) (direction) (nearest town)

WELL PURPOSE: Drinking
 (home, irrigation, municipal, industrial)

- WELL COMPLETION DATA:
- (1) diameter (inches) 2
 - (2) total depth (feet) 63
 - (3) static water level (feet) 10 below above top of ground.
 - (4) casing galv 63
 (material) (depth)
2 if telescope see back.
 (size)
 - (5) screen 5' 63
 (length) (depth to top)
2 Stainless Steel
 (size) (material)
 - (6) pump 1/3 10
 (HP) (yield gpm)
Elect
 (type power)
 - (7) electric log NO
 (yes or no)
 - (organization running log)
 - (8) how well bottom plugged Back Wash Valve

CODED

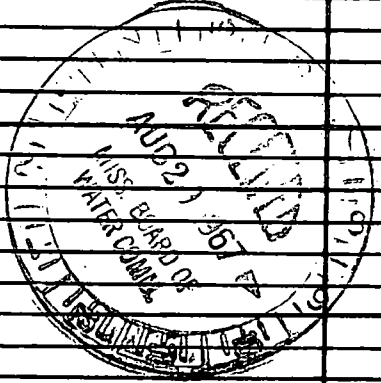

DRILLERS REMARKS:

If well telescopes please sketch and show depths.

GROUND LEVEL

		X	

City

SECTION _____

Please indicate well location X.

ADDITIONAL INFORMATION

If more than one screen, show locations of each on sketch.