

JACKSON  
P 354  
11-72

MISSISSIPPI  
BOARD OF WATER COMMISSIONERS  
416 North State Street  
Jackson, Mississippi 39201

WATER WELL DRILLERS LOG

Colville Water Supply System

date well completed 19 \_\_\_\_\_ firm name \_\_\_\_\_ county well located \_\_\_\_\_

LANDOWNER: James D. Crowe  
Bozotampa Ms  
(mailing address)

description of formations encountered	from	to
sand	0	106
clay	106	339
sand	339	384

WELL LOCATION:  
sec 36 T 7 N R 6 E  
3 miles North of MP  
(distance) (direction) (nearest town)

WELL PURPOSE: home  
(home, irrigation, municipal, industrial)

WELL COMPLETION DATA:

(1) diameter (inches) 2

(2) total depth (feet) 384

(3) static water level (feet) 12'-11" <sup>below</sup> above top of ground.

(4) casing galv 379  
(material) (depth)

(size) if telescope see back.

(5) screen 5 379  
(length) (depth to top)

2 stainless  
(size) (material)

(6) pump 1 12  
(HP) (yield gpm)

elec  
(type power)

(7) electric log no  
(yes or no)

(organization running log)


(8) how well bottom plugged BP Valve

NOV 17 1972

DRILLERS REMARKS:

If well telescopes please sketch and show depths.

GROUND LEVEL

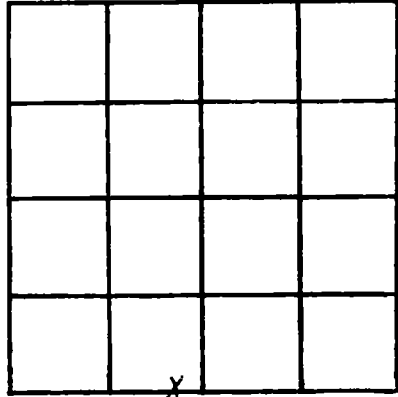

SECTION 36

Please indicate well location X.

ADDITIONAL INFORMATION

A series of horizontal lines for writing additional information, starting below the 'ADDITIONAL INFORMATION' header and extending to the bottom of the page.

If more than one screen, show locations of each on sketch.