

JACKSON
 P355
 Log #209

MS-GW-01414
 MISSISSIPPI
 BOARD OF WATER COMMISSIONERS
 416 North State Street
 Jackson, Mississippi 39201

CODED


WATER WELL DRILLERS LOG

3-16 19 73 SINGER-Layne Central Div. Jackson
 date well completed firm name county well located

| LANDOWNER: | description of formations encountered | from | to |
|---|---------------------------------------|------|-----|
| City of Moss Point | | | |
| Moss Point, Mississippi (mailing address) | Blue Clay | 10 | 15 |
| WELL LOCATION: | Sand & Sea Shells | 15 | 190 |
| sec. 36 T. 7 N. S. R. 6 E. W. | Sandy Clay | 190 | 325 |
| (distance) miles (direction) of (nearest town) | Shale (Hard & Soft) | 325 | 395 |
| WELL PURPOSE: | Sandy Shale | 395 | 420 |
| (home, irrigation, municipal, industrial) | Shale | 420 | 671 |
| WELL COMPLETION DATA: | Sandy Shale | 671 | 693 |
| (1) diameter (inches) 18" | Shale & Sandy Stks | 693 | 760 |
| (2) total depth (feet) 833' | Sand | 760 | 830 |
| (3) static water level (feet) 95' below top of ground | Sandy Shale | 830 | 838 |
| (4) casing Black Steel 760' (material), (depth) | Shale | 838 | 856 |
| 18" (size) if telescope see back. | | | |
| 66' of 10" (length), (depth to top) | | | |
| (5) screen 60' 767' (material) | | | |
| 10" Stainless Steel (size), (material) | | | |
| (6) pump 75 (HP) 700 (yield gpm) | | | |
| Electric (type power) | | | |
| (7) electric log Yes (yes or no) | | | |
| Miss Geo. Survey (organization running log) | | | |
| (8) how well bottom plugged Valve | | | |
| DRILLERS REMARKS: | | | |

If well telescopes please sketch and show depths.

GROUND LEVEL

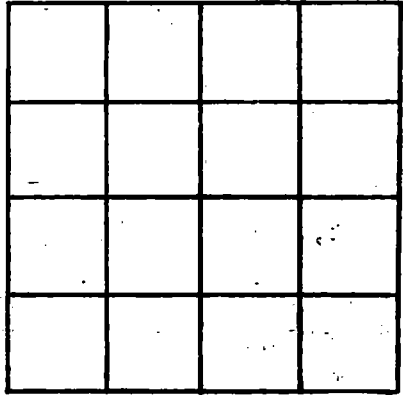

SECTION _____

Please indicate well location X.

ADDITIONAL INFORMATION

If more than one screen, show locations of each on sketch.